

\$7.00
\$2.00

MAY 22 2000

SECTION

LAND CORNER RECORDATION CERTIFICATE
Filing Requirement of Act 74, Mich. P.A. 1970
KENT COUNTY REMONUMENTATION

REG. OF DEEDS

Handwritten signature

STATE OF MICHIGAN
COUNTY OF KENT
RECEIVED FOR RECORD
1999 DEC 27 AM 8:19


For corners in

Kent (County)	Located in: Oakfield Township	Corner Code #
1. Public Land Survey	T <u>9N</u> R <u>9W</u>	<u>J-2</u>
	T _____ R _____	_____
	T _____ R _____	_____
	T _____ R _____	_____
2. Property Controlling in Section	S _____ T _____ R _____	_____
	S _____ T _____ R _____	_____
3. Miscellaneous Property in Sec.	S _____ T _____ R _____	_____
	S _____ T _____ R _____	_____

11647

Register of Deeds Stamp & File Number

- 4. Lot No. _____, Recorded Plat _____
- 5. Private Claims _____

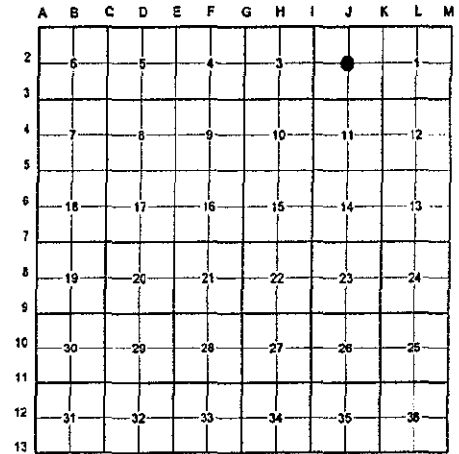

I, Randy Kolehouse, in a field survey on March 8 19 99, do hereby certify that under requirements of P.A. 74 Michigan P.A. of 1970, the corner points mentioned in lines 1 and 2 above were in conformance with regulations and rules therefore as required in the current manual of survey instructions of the United States Department of the interior, Bureau of Land Management or by a decree of a Court of Law and/or that the corner points mentioned in lines 3, 4 and 5 above were in conformance with the rules of the Michigan Board of Land Surveyors or by a Decree of a Court of Law; established, re-established, monumented, re-monumented, recovered, found as expressed below:

NOTE: Not more than 4 corners, all in the same town and range, may be recorded on this certificate.

A. Description of original monument and accessories and/or subsequent restoration:

J-2 This corner was not originally set by the G.L.O.
 1956 Witness Map K.C. Surveyor Iron
 1928-56 Records Williams & Works Iron

P.A. 345 1990 KENT COUNTY
 PEER APPROVED 10/28/99
 CHAIRMAN Handwritten signature

B. Description of corner evidence found and/or method applied in restoring or reestablishing corner:


J-2 Found a 1/2" iron pipe on the C/L of Mac Clain Street (bit.) running East and West, 33.05' North of a plat monument for Horseshoe Lake Estates, per the 1928-56 records of Williams & Works and the the K.C. Surveyor's records. Iron is 0.4' South of the intersection of 1/4 lines. Accepted iron as Center of Section.

The selected location is accepted by me and is generally accepted by professional surveyors as the best available evidence of the position of the original corner.

C. Description of monument for corner and accessories established to perpetuate locating the position of the corner:

J-2 Replaced Iron with a Standard Kent County Monument - Also Set a Monument Box

- Plat mon. South 33.05'
- Nail & K.C. remon. tag on W side 28" Oak S 10° W 30.50'
- Nail & K.C. remon. tag on SW side 10" Pine S 50° E 71.88'
- Nail & K.C. remon. tag on NW side 8" Pine S 60° W 89.44'
- Nail & K.C. remon. tag on W side 8" wood post North 26.12'
- On C/L of (bit.) road running E-W

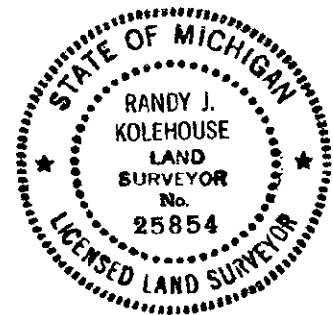

Signed by Randy J. Kolehouse
 WILLIAMS & WORKS

Date 12-20-99

Surveyor's Michigan License No. 25854