

MAY 22 2000

SECTION

LAND CORNER RECORDATION CERTIFICATE  
Filing Requirement of Act 74, Mich. P.A. 1970  
KENT COUNTY REMONUMENTATION.

For corners in

Kent (County)	Located in:	Oakfield Township	Corner Code #
1. Public Land Survey	T <u>9N</u>	R <u>9W</u>	<u>J-3</u>
	T _____	R _____	_____
	T _____	R _____	_____
	T _____	R _____	_____
2. Property Controlling in Section	S _____	T _____	R _____
	S _____	T _____	R _____
3. Miscellaneous Property in Sec.	S _____	T _____	R _____
	S _____	T _____	R _____

REG. OF DEEDS

*[Signature]*

STATE OF MICHIGAN  
COUNTY OF KENT  
RECEIVED FOR RECORD  
1999 OCT 27 AM 8:39

11449

Register of Deeds Stamp & File Number

- 4. Lot No. \_\_\_\_\_, Recorded Plat \_\_\_\_\_
- 5. Private Claims \_\_\_\_\_


I, Randy Kolehouse, in a field survey on February 24 19 99, do hereby certify that under requirements of P.A. 74 Michigan P.A. of 1970, the corner points mentioned in lines 1 and 2 above were in conformance with regulations and rules therefore as required in the current manual of survey instructions of the United States Department of the Interior, Bureau of Land Management or by a decree of a Court of Law and/or that the corner points mentioned in lines 3, 4 and 5 above were in conformance with the rules of the Michigan Board of Land Surveyors or by a Decree of a Court of Law; established, re-established, monumented, re-monumented, recovered, found as expressed below:

**NOTE:** Not more than 4 corners, all in the same town and range, may be recorded on this certificate.

A. Description of original monument and accessories and/or subsequent restoration:

J-3	1837	G.L.O. Notes	Cathcart	Set Post
	1906-1979	Notes	Williams & Works	Stake and Iron
	1986	L.C.R.C. #4404	John Bueche	Fnd. 2" Iron / Set K.C. Monument
	1994	L.C.R.C. #7228	Glaza & Associates	K.C. Monument

P.A. 345 1990 KENT COUNTY  
PEER APPROVED 7/29/99  
CHAIRMAN [Signature]

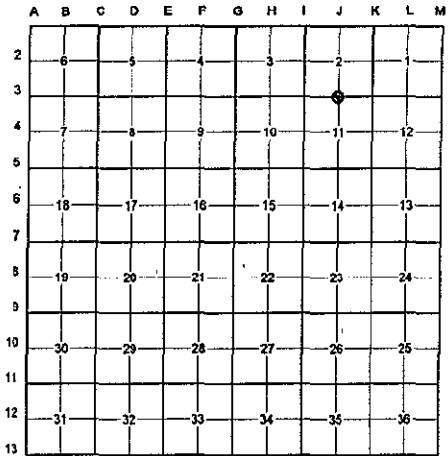

This corner was originally approved by the Kent County Remonumentation Peer Group and monumented by John Bueche on 3/11/86 and was recorded per L.C.R.C. #4404

B. Description of corner evidence found and/or method applied in restoring or reestablishing corner:

J-3 Found a Standard Kent County Monument 8' ± South of the South edge of water, 2' ± North of the North edge of rock headwall running East and West per L.C.R.C.'s #4404 and #7228 as set by John Bueche which checked the 1906 thru 1979 notes of Williams & Works.

L.C.R.C. #4404

L.C.R.C. #7228

NW cor. conc. foundation S 15° E 47.85'  
NE cor. conc. foundation S 50° E 58.36'  
K.C. Remon. tag & nail in N. side 12" Pine S 45° W 47.95'  
K.C. Remon. tag & nail in SE side 10" Pine S 15° W 28.09'  
K.C. Remon. tag & nail in N. side 10" Maple S 80° E 34.39'  
Sea wall South 3.5'  
Lake North 5'+/-


NW corner concrete foundation S15°E 47.85'  
K.C. remon tag & nail in N side 18" Pine S45°W 47.95' (m. 47.90')  
K.C. remon tag & nail in SE side 14" Pine S15°W 28.12'  
K.C. remon tag & nail in N side 12" Maple S80°E 34.41' (m. 34.38')  
Lake North 8'+/-

The selected location is accepted by me and is generally accepted by professional surveyors as the best available evidence of the position of the original corner.

C. Description of monument for corner and accessories established to perpetuate locating the position of the corner:

J-3 Standard Kent County Monument

Nail & K.C. remon. tag on N side 18" Pine S 45° W 47.90'  
Nail & K.C. remon. tag on SE side 14" Pine S 15° W 28.12'  
Nail & K.C. remon. tag on N side 12" Maple S 80° E 34.38'  
NW cor. conc. fndn. S 15° E 47.85'  
Edge of lake North 8' ±

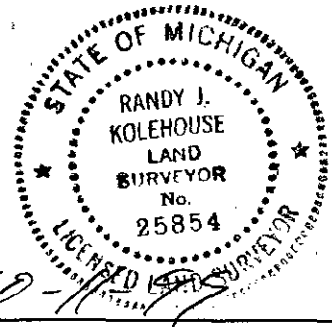

Signed by Randy J. Kolehouse Date 10-11-99

WILLIAMS & WORKS

Surveyor's Michigan License No. 25854