

MAY 22 2000

LAND CORNER RECORDATION CERTIFICATE
Filing Requirement of Act 74, Mich. P.A. 1970
KENT COUNTY REMONUMENTATION

\$7.00
\$2.00

SECTION

For corners in

Kent (County)	Located in: Oakfield Township	Corner Code #
1. Public Land Survey	T <u>9N</u> R <u>9W</u>	<u>J-4</u>
	T _____ R _____	_____
	T _____ R _____	_____
	T _____ R _____	_____
2. Property Controlling in Section	S _____ T _____ R _____	_____
	S _____ T _____ R _____	_____
3. Miscellaneous Property in Sec.	S _____ T _____ R _____	_____
	S _____ T _____ R _____	_____

REG. OF DEEDS


[Signature]

STATE OF MICHIGAN
COUNTY OF KENT
RECEIVED FOR RECORD
1999 DEC 27 AM 8:19

11648

Register of Deeds Stamp & File Number

- 4. Lot No. _____, Recorded Plat _____
- 5. Private Claims _____

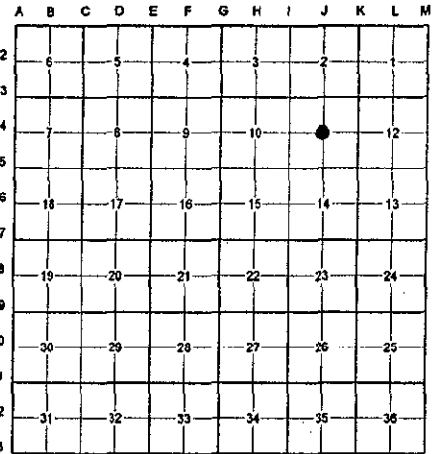

I, Randy Kolehouse, in a field survey on December 16 19 99, do hereby certify that under requirements of P.A. 74 Michigan P.A. of 1970, the corner points mentioned in lines 1 and 2 above were in conformance with regulations and rules therefore as required in the current manual of survey instructions of the United States Department of the Interior, Bureau of Land Management or by a decree of a Court of Law and/or that the corner points mentioned in lines 3, 4 and 5 above were in conformance with the rules of the Michigan Board of Land Surveyors or by a Decree of a Court of Law; established, re-established, monumented, re-monumented, recovered, found as expressed below:

NOTE: Not more than 4 corners, all in the same town and range, may be recorded on this certificate.

A. Description of original monument and accessories and/or subsequent restoration:

- J-4 This corner was not originally set by the G.L.O.
- | | | | |
|------|----------------|------------------|---------------------------------|
| 1906 | Survey Records | Williams & Works | Stake |
| 1930 | Survey Records | Williams & Works | Triangle Stone of Squared Stake |

P.A. 345 1990 KENT COUNTY
PEER APPROVED 12/20/99
CHAIRMAN [Signature]

B. Description of corner evidence found and/or method applied in restoring or reestablishing corner:

- J-4 Found no field evidence of this corner. Checked with Rob Jonker at Jonker Land Surveys and found that he is preparing a new subdivision in the Northeast 1/4 of Section and is using the intersection of 1/4 lines for this center; found Jonker irons 300' North and 240' East of center of section. Calc. center of section shown in the Williams & Works' notes of 1930 was approximately 33' East and 21' North (did not find). Set reference monuent using the center as established by Jonker Land Surveys.

The selected location is accepted by me and is generally accepted by professional surveyors as the best available evidence of the position of the original corner.

C. Description of monument for corner and accessories established to perpetuate locating the position of the corner:

- | | |
|--|--|
| J-4 Replaced Iron with a Kent County Ref. Mon. 300' North of J-4 | Set a Kent County Ref. Mon. 181.04' East of J-4 |
| Nail & K.C. remon. tag on W side 15" Pine N 10° E 20.64' | Nail & K.C. remon. tag on SW side 15" Oak N 15° W 14.55' |
| Nail & K.C. remon. tag on SE side 24" Pine N 40° E 27.75' | Nail & K.C. remon. tag on SE side 15" Oak N 30° E 21.40' |
| Nail & K.C. remon. tag on N side twin 12" Oak S 85° E 41.49' | Nail & K.C. remon. tag on S side 24" Pine S 85° E 29.75' |
| Nail & K.C. remon. tag W side 10" Oak S 05° W 18.51' | Nail & K.C. remon. tag on W side 30" Pine S 25° E 10.89' |
| Nail & K.C. remon. tag S side 8" Pine S 85° W 17.55' | Nail & K.C. remon. tag on N side 24" Oak S 80° W 41.45' |
| C/L creek NW 25'+/- | Jonker capped iron East 58.5' |

Signed by [Signature]
WILLIAMS & WORKS

Date 12-20-99

Surveyor's Michigan License No. 25854

