

MAY 22 2000

**SECTION LAND CORNER RECORDATION CERTIFICATE**  
 Filing Requirement of Act 74, Mich. P.A. 1970  
 KENT COUNTY REMONUMENTATION

\$7.00  
 \$2.00

For corners in

Kent (County)	Located in: Oakfield Township	Corner Code #
1. Public Land Survey	T <u>9N</u> R <u>9W</u>	<u>J-6</u>
	T _____ R _____	_____
	T _____ R _____	_____
	T _____ R _____	_____
2. Property Controlling in Section	S _____ T _____ R _____	_____
	S _____ T _____ R _____	_____
3. Miscellaneous Property in Sec.	S _____ T _____ R _____	_____
	S _____ T _____ R _____	_____

STATE OF MICHIGAN  
 COUNTY OF KENT  
 RECEIVED FOR RECORD  
 1999 DEC 27 AM 8:19  
 REG. OF DEEDS

11649

Register of Deeds Stamp & File Number

4. Lot No. \_\_\_\_\_, Recorded Plat \_\_\_\_\_  
 5. Private Claims \_\_\_\_\_

	A	B	C	D	E	F	G	H	I	J	K	L	M
2	6		5		4		3		2		1		
3													
4	7		8		9		10		11		12		
5													
6	16		17		18		15		13		14		
7													
8	19		20		21		22		23		24		
9													
10	30		29		28		27		26		25		
11													
12	31		32		33		34		35		36		
13													

I, Randy Kolehouse, in a field survey on March 16 19 99, do hereby certify that under requirements of P.A. 74 Michigan P.A. of 1970, the corner points mentioned in lines 1 and 2 above were in conformance with regulations and rules therefore as required in the current manual of survey instructions of the United States Department of the Interior, Bureau of Land Management or by a decree of a Court of Law and/or that the corner points mentioned in lines 3, 4 and 5 above were in conformance with the rules of the Michigan Board of Land Surveyors or by a Decree of a Court of Law; established, re-established, monumented, re-monumented, recovered, found as expressed below:

**NOTE: Not more than 4 corners, all in the same town and range, may be recorded on this certificate.**

A. Description of original monument and accessories and/or subsequent restoration:

J-6 This corner was not originally set by the G.L.O.  
 1992 Twin Creek Estates Nederveld & Assoc. Iron

P.A. 345 1990 KENT COUNTY  
 PEER APPROVED 12/02/99  
 CHAIRMAN Harry Huber


B. Description of corner evidence found and/or method applied in restoring or reestablishing corner:

J-6 Found a capped Nederveld & Associates iron as set by Nederveld Associates at the intersection of 1/4 lines. This found rebar is 0.9'+/- West and 0.2' North of intersection of 1/4 lines. Held iron as Center of Section.

The selected location is accepted by me and is generally accepted by professional surveyors as the best available evidence of the position of the original corner.

C. Description of monument for corner and accessories established to perpetuate locating the position of the corner:

J-6 Replaced capped iron with a Standard Kent County Monument  
 Nail & K.C. remon. tag on SW side 18" Oak N 30° W 26.91'  
 Nail & K.C. remon. tag on NW side 12" Oak N 45° E 19.43'  
 Nail & K.C. remon. tag on S'y side 10" Oak S 75° E 29.80'  
 Nail & K.C. remon. tag on E side 10" Maple S 05° W 25.54'  
 Nail & K.C. remon. tag on SE side 10" Pine S 45° W 39.73'

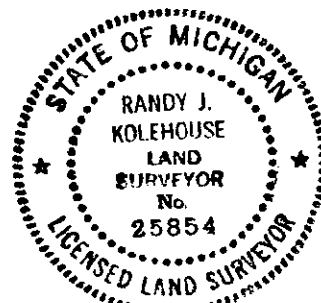

Signed by Randy J. Kolehouse Date 12-20-99  
 WILLIAMS & WORKS  
 Surveyor's Michigan License No. 25854