

MAY 22 2000

\$7.00  
\$2.00

SECTION

LAND CORNER RECORDATION CERTIFICATE  
Filing Requirement of Act 74, Mich. P.A. 1970  
KENT COUNTY REMONUMENTATION

For corners in

Kent (County)	Located in:	Oakfield Township	Corner Code #
1. Public Land Survey	T 9N	R 9W	J-7
	T	R	
	T	R	
	T	R	
2. Property Controlling in Section	S	T	R
	S	T	R
3. Miscellaneous Property in Sec.	S	T	R
	S	T	R

REG. OF DEEDS


*[Signature]*

STATE OF MICHIGAN  
COUNTY OF KENT  
RECEIVED FOR RECORD  
1999 DEC - 8 AM 10:10

11568

Register of Deeds Stamp & File Number

4. Lot No. \_\_\_\_\_, Recorded Plat \_\_\_\_\_  
5. Private Claims \_\_\_\_\_

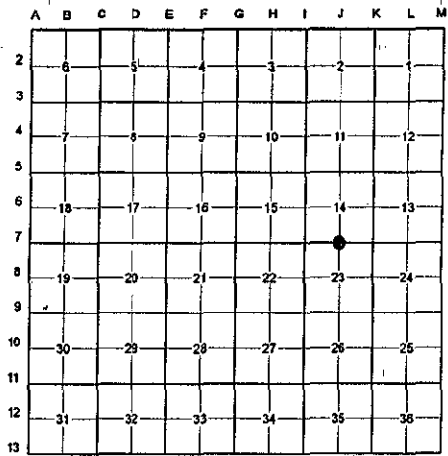

I, Randy Kolehouse, in a field survey on March 16 19 99, do hereby certify that under requirements of P.A. 74 Michigan P.A. of 1970, the corner points mentioned in lines 1 and 2 above were in conformance with regulations and rules therefore as required in the current manual of survey instructions of the United States Department of the interior, Bureau of Land Management or by a decree of a Court of Law and/or that the corner points mentioned in lines 3, 4 and 5 above were in conformance with the rules of the Michigan Board of Land Surveyors or by a Decree of a Court of Law; established, re-established, monumented, re-monumented, recovered, found as expressed below:

NOTE: Not more than 4 corners, all in the same town and range, may be recorded on this certificate.

A. Description of original monument and accessories and/or subsequent restoration:

J-7	1837	G.L.O. Notes	Cathcart	Set Post
	1976	L.C.R.C. #921	James Porter	1/2" Rerod
	1985	L.C.R.C. #4276	Thomas Chettleburgh	Set K.C. Monument
	1994	L.C.R.C. #7230	Glaza & Associates	K.C. Monument

P.A. 345 1990 KENT COUNTY  
PEER APPROVED 10/28/99  
CHAIRMAN [Signature]

This corner was originally approved by the Kent County Remonumentation Peer Group and monumented by Thomas Chettleburgh on 8/22/85 and was recorded per L.C.R.C. #4276.

B. Description of corner evidence found and/or method applied in restoring or reestablishing corner:

J-7 Found a Standard Kent County Monument in the middle of a woods with no occupation per L.C.R.C.'s #4276 and #7230 as set by Thomas Chettleburgh by single proportionate measurement as no corner evidence remained.

L.C.R.C. #4276

L.C.R.C. #7230

Nail/tag SW side 21" White Pine N75W 34.87'  
Nail/tag NW side 22" White Pine N24E 11.62'  
Nail/tag S side 16" Oak N85E 52.01'  
Nail/tag SW side 8" Oak S32E 24.83'  
Nail/tag NW side 9" Oak S24W 47.40'

Nail & K.C. remon tag in SW side 24" White Pine N75°W 34.87' (m. 34.92')  
Nail & K.C. remon tag in NW side 24" White Pine N24°E 11.62'  
Nail & K.C. remon tag in S side 18" Oak N85°E 52.01' (m. 52.07')  
Nail & K.C. remon tag in S side 18" Oak S32°E 24.83' (m. 24.82')  
Nail & K.C. remon tag in NW side 12" Oak S24°W 47.40' (m. 47.43')

The selected location is accepted by me and is generally accepted by professional surveyors as the best available evidence of the position of the original corner.

C. Description of monument for corner and accessories established to perpetuate locating the position of the corner:

J-7 Standard Kent County Monument

Nail & K.C. remon. tag on SW side 24" White Pine N 75° W 34.92'  
Nail & K.C. remon. tag on NW side 24" White Pine N 24° E 11.62'  
Nail & K.C. remon. tag on S side 18" Oak N 85° E 52.07'  
Nail & K.C. remon. tag on SW side 10" Oak S 32° E 24.82'  
Nail & K.C. remon. tag on NW side 12" Oak S 24° W 47.43'

Signed by Randy J. Kolehouse Date \_\_\_\_\_

WILLIAMS & WORKS

Surveyor's Michigan License No. 25854

