

MAY 22 2000

\$7.00
\$2.00

SECTION

LAND CORNER RECORDATION CERTIFICATE
Filing Requirement of Act 74, Mich. P.A. 1970
KENT COUNTY REMONUMENTATION

For corners in

<u>Kent</u> (County)	Located in: <u>Oakfield</u> Township	Corner Code # <u>J-8</u>
1. Public Land Survey	T <u>9N</u> R <u>9W</u>	<u>J-8</u>
	T _____ R _____	_____
	T _____ R _____	_____
	T _____ R _____	_____
2. Property Controlling in Section	S _____ T _____ R _____	_____
	S _____ T _____ R _____	_____
3. Miscellaneous Property in Sec.	S _____ T _____ R _____	_____
	S _____ T _____ R _____	_____
4. Lot No. _____, Recorded Plat _____		
5. Private Claims _____		

REG. OF DEEDS


11685

Register of Deeds Stamp & File Number

STATE OF MICHIGAN
COUNTY OF KENT
RECEIVED FOR RECORD

1999 DEC 30 AM 9:20

I, Randy Kolehouse, in a field survey on December 17 19 99, do hereby certify that under requirements of P.A. 74 Michigan P.A. of 1970, the corner points mentioned in lines 1 and 2 above were in conformance with regulations and rules therefore as required in the current manual of survey instructions of the United States Department of the interior, Bureau of Land Management or by a decree of a Court of Law and/or that the corner points mentioned in lines 3, 4 and 5 above were in conformance with the rules of the Michigan Board of Land Surveyors or by a Decree of a Court of Law; established, re-established, monumented, re-monumented, recovered, found as expressed below:

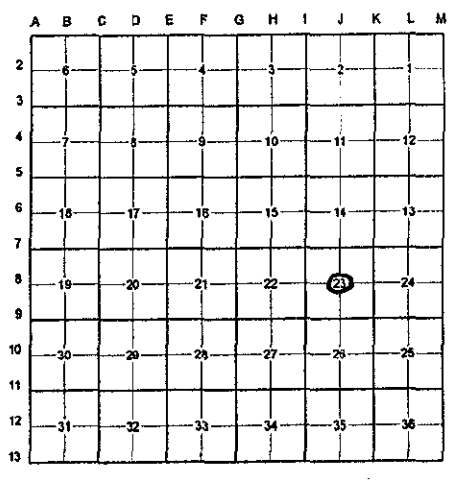

NOTE: Not more than 4 corners, all in the same town and range, may be recorded on this certificate.


A. Description of original monument and accessories and/or subsequent restoration:
 J-8 This corner was not originally set by the G.L.O.
 No information on record.

P.A. 345 1990 KENT COUNTY
 PEER APPROVED 12/02/99
 CHAIRMAN [Signature]

B. Description of corner evidence found and/or method applied in restoring or reestablishing corner:
 J-8 This corner falls in the center of the School for the Blind property. Found no record information of this corner being set. Set corner at the intersection of 1/4 lines 1' North of a barbed wire fence running West and 10' West of a fence running South.

The selected location is accepted by me and is generally accepted by professional surveyors as the best available evidence of the position of the original corner.

C. Description of monument for corner and accessories established to perpetuate locating the position of the corner:
 J-8 Set a Standard Kent County Monument
 Nail & K.C. remon. tag on N face 10" fence corner post S 80° E 10.17'
 Nail & K.C. remon. tag on NE face 14" Oak N 23° W 7.57'
 Nail & K.C. remon. tag on E face 8" Wild Cherry N 25° E 31.92'
 Nail & K.C. remon. tag on E face 12" Twin Oak S 00° E 27.27'
 Fence running W, South 1'
 Fence running S, East 10'

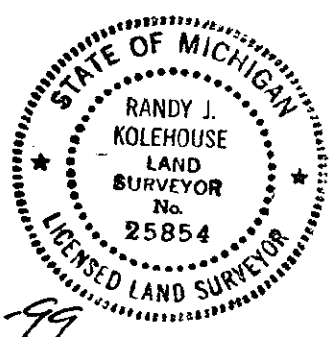

Signed by [Signature] Date 12-28-99
 WILLIAMS & WORKS
 Surveyor's Michigan License No. 25854