

MAY 22 2000

SECTION

LAND CORNER RECORDATION CERTIFICATE
Filing Requirement of Act 74, Mich. P.A. 1970
KENT COUNTY REMONUMENTATION

For corners in

Table with columns: Kent (County), Located in: Oakfield Township, Corner Code #. Rows include Public Land Survey, Property Controlling in Section, Miscellaneous Property in Sec.

4. Lot No. , Recorded Plat
5. Private Claims


I, Randy Kolehouse, in a field survey on July 13 19 99, do hereby certify that under requirements of P.A. 74 Michigan P.A. of 1970, the corner points mentioned in lines 1 and 2 above were in conformance with regulations and rules therefore as required in the current manual of survey instructions of the United States Department of the interior, Bureau of Land Management or by a decree of a Court of Law and/or that the corner points mentioned in lines 3, 4 and 5 above were in conformance with the rules of the Michigan Board of Land Surveyors or by a Decree of a Court of Law; established, re-established, monumented, re-monumented, recovered, found as expressed below:

NOTE: Not more than 4 corners, all in the same town and range, may be recorded on this certificate.

A. Description of original monument and accessories and/or subsequent restoration:

Table with columns: J-11, 1837, 1978, 1981, 1994, G.L.O. Notes, L.C.R.C. #1159, L.C.R.C. #1859, L.C.R.C. #7232, Cathcart, C.S. Hay, Jonker Land Surveys, Glaza & Associates, Set Post, Iron and Cap, Fnd. Iron & Cap - Set K.C. Monument, K.C. Monument

P.A. 345 1990 KENT COUNTY PEER APPROVED 7/29/99 CHAIRMAN [Signature]

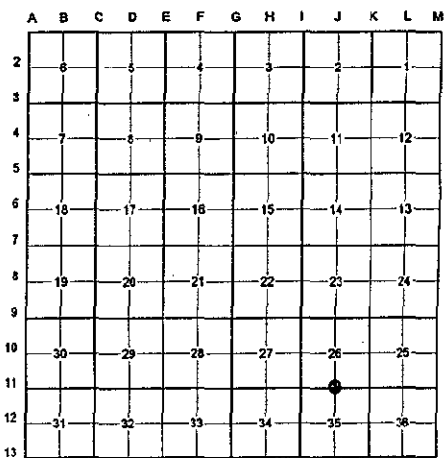

This corner was originally approved by the Kent County Remonumentation Peer Group and monumented by Rob Jonker on 5/28/81 and was recorded per L.C.R.C. #1859.

B. Description of corner evidence found and/or method applied in restoring or reestablishing corner:

J-11 Found a Standard Kent County Monument 2' +/- West of the C/L of Tully Avenue (gravel) running North and South and 2' +/- North of the C/L of 11 Mile Road (gravel) running East and West per L.C.R.C.'s #1859 and #7232 as set by Rob Jonker in place of an iron and cap he found which checked with L.C.R.C. #1159.

L.C.R.C. #1859

L.C.R.C. #7232

K.C. remon. tag on NE side wooden fe. Post S45°E 40.20'
K.C. remon. tag on S. side 22" hickory N80°E 80.03'


K.C. remon tag & nail in NE side wooden fence post S50°E 40.20' (m. 40.24')
K.C. remon tag & nail in S side 24" Hickory N75°E 79.97' (m. 79.79')

The selected location is accepted by me and is generally accepted by professional surveyors as the best available evidence of the position of the original corner.

C. Description of monument for corner and accessories established to perpetuate locating the position of the corner:

J-11 Standard Kent County Monument

- Nail & K.C. remon. tag on NE side wood fence post S 50° E 40.24'
Nail & K.C. remon. tag on S side 26" Hickory N 75° E 79.79'
Nail & K.C. remon. tag on W side P. pole N 25° E 98.12'
Nail & K.C. remon. tag on S side 18" Oak S 53° W 134.22'
Nail & K.C. remon. tag on E side 10" triple Birch N 09° W 137.47'
C/L of gravel road running N-S, East 2' +/-
C/L of gravel road running E-W, South 2' +/-

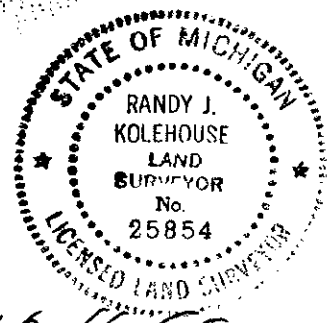

Signed by [Signature] Date 10-11-99

WILLIAMS & WORKS

Surveyor's Michigan License No. 25854