

SURVEY & REMONUMENTATION

\$7.00
\$2.00

MAR 08 1999

LAND CORNER RECORDATION CERTIFICATE
Filing Requirement of Act 74, Mich. P.A. 1970
KENT COUNTY REMONUMENTATION

For corners in SECTION _____

Kent (County)	Located in:	Oakfield Township	Corner Code #
1. Public Land Survey	T 9N	R 9W	J-13
	T _____	R _____	_____
	T _____	R _____	_____
	T _____	R _____	_____
2. Property Controlling in Section	S _____	T _____	R _____
	S _____	T _____	R _____
3. Miscellaneous Property in Sec.	S _____	T _____	R _____
	S _____	T _____	R _____

REG. OF DEEDS

Handwritten signature

38 DEC 14 AM 8:00

STATE OF MICHIGAN
COUNTY OF KENT
RECEIVED FOR RECORD

11016

Register of Deeds Stamp & File Number

4. Lot No. _____, Recorded Plat _____
5. Private Claims _____

I, Randy Kolehouse, in a field survey on December 3 19 98, do hereby certify that under requirements of P.A. 74 Michigan P.A. of 1970, the corner points mentioned in lines 1 and 2 above were in conformance with regulations and rules therefore as required in the current manual of survey instructions of the United States Department of the interior, Bureau of Land Management or by a decree of a Court of Law and/or that the corner points mentioned in lines 3, 4 and 5 above were in conformance with the rules of the Michigan Board of Land Surveyors or by a Decree of a Court of Law; established, re-established, monumented, re-monumented, recovered, found as expressed below:

NOTE: Not more than 4 corners, all in the same town and range, may be recorded on this certificate.

A	B	C	D	E	F	G	H	I	J	K	L	M
2	6	5	4	3	2	1						
3												
4	7	8	9	10	11	12						
5												
6	18	17	16	15	14	13						
7												
8	19	20	21	22	23	24						
9												
10	30	29	28	27	26	25						
11												
12	31	32	33	34	35	36						
13												

A. Description of original monument and accessories and/or subsequent restoration:

J-13	1837	G.L.O. Notes	N. Brookfield	Set Post
	1981	L.C.R.C. #2071	Nederveld & Jonker	Set Capped Iron
	1982	L.C.R.C. #2868	Jonker Land Survey	Fnd. Capped Rerod / Set K.C. Monument
	1985	L.C.R.C. #4269	William Byl	Reset K.C. Monument (Corrected Position of Corner)
	1994	L.C.R.C. #7233	Glaza & Associates	K.C. Monument P.A. 345 1990 KENT COUNTY

PEER APPROVED 9/24/98
CHAIRMAN *Handwritten signature*

Note: This corner is not common with J-1, T8N, R9W.

This corner was originally approved by the Kent County Remonumentation Peer Group and monumented by Rob Jonker on 5/18/82 and was recorded per L.C.R.C. #2868. Position corrected by William Byl on 7/1/85, approved by the Kent County Remonumentation Peer Group, and recorded per L.C.R.C. #4269.

B. Description of corner evidence found and/or method applied in restoring or reestablishing corner:

J-13: Found a Standard Kent County Monument 350' ± South of the intersection of Ten Mile Road (gravel) running East and West and Tully Road (gravel) running North per L.C.R.C.'s #4269 and #7233 as reset in 1985 by William Byl.

L.C.R.C. #4269

L.C.R.C. #7233


- Nail & tag, N sd. 8" Maple N 80°E 7.79'
- Nail & tag, W sd. 8" Maple cluster N 15°E 31.07'
- Nail & tag, N sd. 15" Maple N 80°W 26.71'
- Nail & tag, W sd. 12" Triple Maple S 35°E 13.48'
- Kent Co. Monument @ N1/4 cor. Sec. 2, 8-9 S 90°W 103.42'

- Nail & K.C. remon tag in N side 8" Maple N80°E 7.79' (m. 8.00')
- Nail & K.C. remon tag in W side 8" maple cluster N15°E 31.07' (m. 31.10')
- Nail & K.C. remon tag in W side 12" Triple Maple S35°E 13.41' (m. 13.43')
- Kent Co Mon (m 1/4 cor, Sec 2, T8N, R9W) S90°W 103.42'

The selected location is accepted by me and is generally accepted by professional surveyors as the best available evidence of the position of the original corner.

C. Description of monument for corner and accessories established to perpetuate locating the position of the corner:

- J-13 Standard Kent County Monument
- Nail & K.C. remon. tag on N side 8" Maple N 80° E 8.00'
 - Nail & K.C. remon. tag on W side 8" Maple cluster N 15° E 31.10'
 - Nail & K.C. remon. tag on W side 12" tri. Maple S 35° E 13.43'
 - Nail & K.C. remon. tag on N side 15" Maple N 80° W 26.80'
 - K.C. Mon. J-1, T8N, R9W, S 90° W 103.44'
 - C/L "X" of gravel roads running E-W-N, North 350' ±

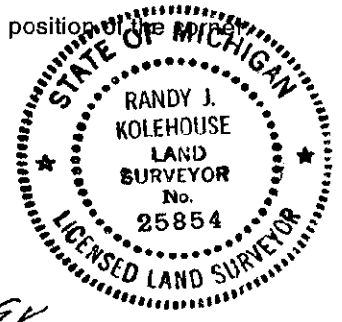

Signed by *Handwritten signature* Date 12/5/98

Surveyor's Michigan License No. 25854