

MAY 22 2000

LAND CORNER RECORDATION CERTIFICATE
Filing Requirement of Act 74, Mich. P.A. 1970
KENT COUNTY REMONUMENTATION

STATE OF MICHIGAN
COUNTY OF KENT
RECEIVED FOR RECORD
1999 OCT 27 AM 8:39

REG. OF DEEDS

For corners in

SECTION

Table with columns: Kent (County), Located in: Oakfield Township, Corner Code #. Rows include Public Land Survey, Property Controlling in Section, and Miscellaneous Property in Sec.


11452

Register of Deeds Stamp & File Number

4. Lot No. Recorded Plat
5. Private Claims

I, Randy Kolehouse, in a field survey on March 8, 1999, do hereby certify that under requirements of P.A. 74 Michigan P.A. of 1970, the corner points mentioned in lines 1 and 2 above were in conformance with regulations and rules therefore as required in the current manual of survey instructions of the United States Department of the interior, Bureau of Land Management or by a decree of a Court of Law and/or that the corner points mentioned in lines 3, 4 and 5 above were in conformance with the rules of the Michigan Board of Land Surveyors or by a Decree of a Court of Law; established, re-established, monumented, re-monumented, recovered, found as expressed below:

NOTE: Not more than 4 corners, all in the same town and range, may be recorded on this certificate.

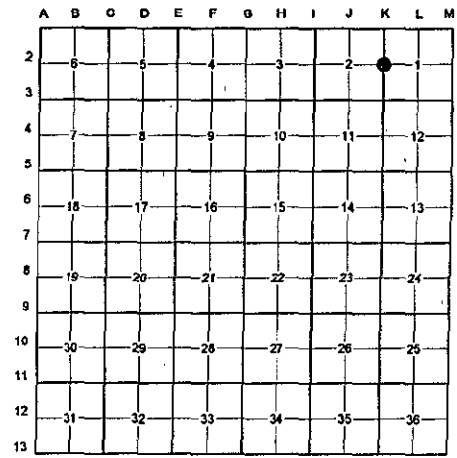

A. Description of original monument and accessories and/or subsequent restoration:

Table with columns: K-2, 1837, 1932, 1983, 1987, 1994. Rows describe G.L.O. Notes, Witness Map, L.C.R.C. #3327, L.C.R.C. #4533, L.C.R.C. #7235, Cathcart, K.C. Surveyor, Glaza & Associates, John C. Bueche, Glaza & Associates, Set Post, Monument, Conc. Monument, Fnd. Conc. Monument - Set K.C. Monument, K.C. Monument.

P.A. 345 1990 KENT COUNTY

PEER APPROVED 7/29/99
CHAIRMAN [Signature]

This corner was originally approved by the Kent County Remonumentation Peer Group and monumented by John Bueche on 3/11/86 and was recorded per L.C.R.C. #4533.

B. Description of corner evidence found and/or method applied in restoring or reestablishing corner:

K-2 Found a Standard Kent County Monument 100' +/- South of the C/L of McClain Street (bit.) running Easterly and Westerly at the edge of Woodbeck Lake per L.C.R.C.'s #4533 and #7235 as set by John Bueche in place of a concrete monument he found which checked L.C.R.C. #3327 and the K.C. Surveyor's records.

L.C.R.C. #4533

L.C.R.C. #7235

K.C. remon. tag & nail in N. side 8" Elm N 70° E 8.00'
K.C. remon. tag & nail in E. side 8" Birch S 55° W 49.89'


K.C. remon tag & nail in N side 10" Elm N70°E 7.86'
K.C. remon tag & nail in E side 10" Beech S55°W 51.11' (m. 50.11')
1' to edge of water
North 100'+/- to C/L McClain Street

The selected location is accepted by me and is generally accepted by professional surveyors as the best available evidence of the position of the original corner.

C. Description of monument for corner and accessories established to perpetuate locating the position of the corner:

K-2 Standard Kent County Monument

- Nail & K.C. remon. tag on N side 10" Elm N 70° E 7.86'
Nail & K.C. remon. tag on E side 10" Birch S 55° W 50.11'
Nail & K.C. remon. tag on W side 6" Maple N 45° W 33.73'
Nail & K.C. remon. tag on E side 6" Maple S 20° W 25.24'
C/L of bit. road running E'ly & W'ly, North 100'
On edge of lake

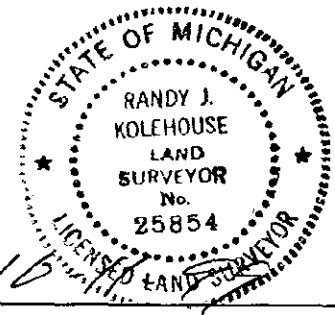

Signed by [Signature] Date

WILLIAMS & WORKS

Surveyor's Michigan License No. 25854