

MAY 22 2000

\$7.00  
\$2.00

SECTION

LAND CORNER RECORDATION CERTIFICATE  
Filing Requirement of Act 74, Mich. P.A. 1970  
KENT COUNTY REMONUMENTATION

For corners in

Kent (County)	Located in: Oakfield Township	Corner Code #
1. Public Land Survey	T <u>9N</u> R <u>9W</u>	<u>K-3</u>
	T _____ R _____	_____
	T _____ R _____	_____
	T _____ R _____	_____
2. Property Controlling in Section	S _____ T _____ R _____	_____
	S _____ T _____ R _____	_____
3. Miscellaneous Property in Sec.	S _____ T _____ R _____	_____
	S _____ T _____ R _____	_____

REG. OF DEEDS

*[Signature]*

STATE OF MICHIGAN  
COUNTY OF KENT  
RECEIVED FOR RECORD  
1999 DEC 27 AM 8:19


11652

Register of Deeds Stamp & File Number

4. Lot No. \_\_\_\_\_, Recorded Plat \_\_\_\_\_  
5. Private Claims \_\_\_\_\_

I, Randy Kolehouse, in a field survey on February 24 19 99, do hereby certify that under requirements of P.A. 74 Michigan P.A. of 1970, the corner points mentioned in lines 1 and 2 above were in conformance with regulations and rules therefore as required in the current manual of survey instructions of the United States Department of the Interior, Bureau of Land Management or by a decree of a Court of Law and/or that the corner points mentioned in lines 3, 4 and 5 above were in conformance with the rules of the Michigan Board of Land Surveyors or by a Decree of a Court of Law; established, re-established, monumented, re-monumented, recovered, found as expressed below:

NOTE: Not more than 4 corners, all in the same town and range, may be recorded on this certificate.

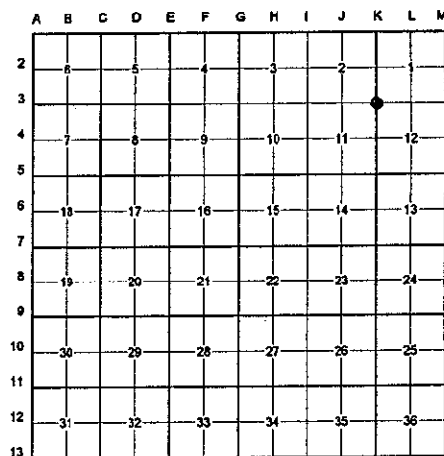

A. Description of original monument and accessories and/or subsequent restoration:

K-3	1837	G.L.O. Notes	Cathcart	Set Post
	1906	Notes	Williams & Works	Set Stake & Stone
	N/A	Witness Map	K.C. Surveyor	Stake & Stone
	1986	L.C.R.C. #4405	John Bueche	Fnd. Stone / Set K.C. Monument
	1994	L.C.R.C. #7236	Glaza & Associates	K.C. Monument

P.A. 345 1990 KENT COUNTY  
PEER APPROVED 7/29/99  
CHAIRMAN [Signature]

This corner was originally approved by the Kent County Remonumentation Peer Group and monumented by John Bueche on 2/26/86 and was recorded per L.C.R.C. #4405.

B. Description of corner evidence found and/or method applied in restoring or reestablishing corner:

K-3 Found a Standard Kent County Monument on line of a fence line running East and a downed fence line running North per L.C.R.C. #4405 and #7236 as set by John Bueche in place of a stone he found which checked the 1906 notes of Williams & Works and the K.C. Surveyor's records.

L.C.R.C. #4405

L.C.R.C. #7236

K.C. Remon. tag & nail in S. side 12" Oak N 75° E 19.52'  
K.C. Remon. tag & nail in SW side 8" Oak S 35° E 11.04'  
K.C. Remon. tag & nail in NW 8" Oak S 35° W 12.32'  
K.C. Remon. tag & nail in S. side 36" Oak N 80° W 24.55'  
K.C. Remon. tag & nail in W. side 8" Maple N 10° W 23.95'  
K.C. Remon. tag & nail in 8" Oak N 30° E 48.45'  
On fence East and North


K.C. remon. tag & nail in S side 12" Oak N75°E 19.52' (m. 19.49')  
K.C. remon. tag & nail in SW side 8" Oak S35°E 11.00' (m. 10.98')  
K.C. remon. tag & nail in NW side 10" Oak S35°W 12.32' (m. 12.29')  
K.C. remon. tag & nail in S side 36" Oak N80°W 24.55'  
K.C. remon. tag & nail in W side 10" Maple N10°W 23.93' (m. 23.95')  
K.C. remon. tag & nail in SE side 10" Oak N30°E 48.44' (m. 48.46')  
On fence East and North

The selected location is accepted by me and is generally accepted by professional surveyors as the best available evidence of the position of the original corner.

C. Description of monument for corner and accessories established to perpetuate locating the position of the corner:

K-3 Standard Kent County Monument

Nail & K.C. remon. tag on S side 12" Oak N 75° E 19.49'  
Nail & K.C. remon. tag on SW side 8" Oak S 35° E 10.98'  
Nail & K.C. remon. tag on NW side 10" Oak S 35° W 12.29'  
Nail & K.C. remon. tag on S side 36" Oak N 80° W 24.55'  
Nail & K.C. remon. tag on W side 10" Maple N 10° W 23.95'  
Nail & K.C. remon. tag on SE side 10" Oak N 30° E 48.46'  
On fence line running E  
On downed fence line running N

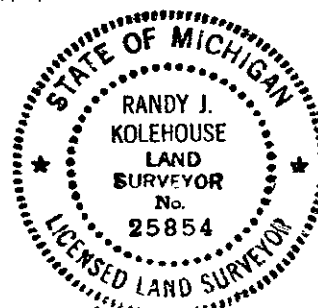

Signed by Randy Kolehouse

Date 10-22-99

Surveyor's Michigan License No. 25854