

MAY 22 2000

\$7.00
\$2.00

SECTION

LAND CORNER RECORDATION CERTIFICATE
Filing Requirement of Act 74, Mich. P.A. 1970
KENT COUNTY REMONUMENTATION

For corners in

Kent (County)	Located in: Oakfield Township	Corner Code #
1. Public Land Survey	T 9N R 9W	K-4
	T R	
	T R	
	T R	
2. Property Controlling in Section	S T R	
	S T R	
3. Miscellaneous Property in Sec.	S T R	
	S T R	

4. Lot No. _____, Recorded Plat _____
5. Private Claims _____

REG. OF DEEDS

[Signature]


STATE OF MICHIGAN
COUNTY OF KENT
RECEIVED FOR RECORD
1999 DEC - 8 AM 10:10

11570

Register of Deeds Stamp & File Number

I, Randy Kolehouse in a field survey on September 29 19 99, do hereby certify that under requirements of P.A. 74 Michigan P.A. of 1970, the corner points mentioned in lines 1 and 2 above were in conformance with regulations and rules therefore as required in the current manual of survey instructions of the United States Department of the interior, Bureau of Land Management or by a decree of a Court of Law and/or that the corner points mentioned in lines 3, 4 and 5 above were in conformance with the rules of the Michigan Board of Land Surveyors or by a Decree of a Court of Law; established, re-established, monumented, re-monumented, recovered, found as expressed below:

NOTE: Not more than 4 corners, all in the same town and range, may be recorded on this certificate.

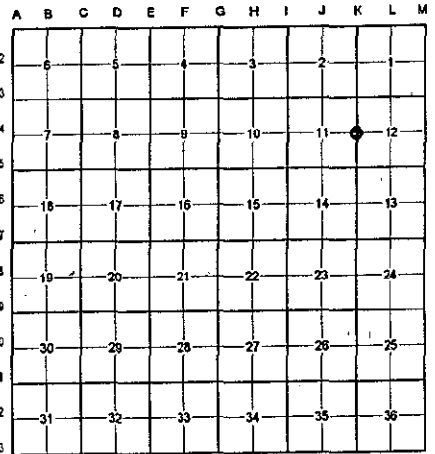

A. Description of original monument and accessories and/or subsequent restoration:

K-4	1837	G.L.O. Notes	Cathcart	Set Post
	1979 ±	N/A	Nederveld & Assoc.	Capped Iron
	1991	L.C.R.C. #5754	Kevin Roosien	Fnd. Capped Iron / Set K.C. Monument
	1994	L.C.R.C. #7237	Glaza & Associates	K.C. Monument

P.A. 345 1990 KENT COUNTY

PEER APPROVED 10/28/99

CHAIRMAN *[Signature]*

This corner was originally approved by the Kent County Remonumentation Peer Group and monumented by Kevin Roosien in December 1990 and was recorded per L.C.R.C. #5754.

B. Description of corner evidence found and/or method applied in restoring or reestablishing corner:

K-4 Found a Standard Kent County Monument in a wooded area 3.7' ± East of a fence corner with fence lines running West and South per L.C.R.C.'s #5754 and #7237 as set by Kevin Roosien in place of a Nederveld capped iron he found by physical evidence.

L.C.R.C. #5754

- Nail in K.C. tag in E. side 30" Ash S10°E 13.15'
- Nail in K.C. tag in S. side 8" Ash N70°E 16.94'
- Nail in K.C. tag in E. side 6" Ash N15°E 18.24'
- Nail in K.C. tag in N. side 6" Ash N85°W 3.75'

L.C.R.C. #7237


- K.C. remon tag & nail in E side 30" Ash S10°E 13.15' (m. 13.13')
- K.C. remon tag & nail in S side 12" Ash N70°E 16.94'
- K.C. remon tag & nail in E side 8" Ash N15°E 18.24'
- K.C. remon tag & nail in N side 10" Ash N85°W 3.75'

The selected location is accepted by me and is generally accepted by professional surveyors as the best available evidence of the position of the original corner.

C. Description of monument for corner and accessories established to perpetuate locating the position of the corner:

K-4 Standard Kent County Monument

- Nail & K.C. remon. tag on E side 30" Ash S 10° E 13.13'
- Nail & K.C. remon. tag on S side 12" Ash N 70° E 16.94'
- Nail & K.C. remon. tag on E side 6" Ash N 15° E 18.24'
- Nail & K.C. remon. tag on N side 10" Ash N 85° W 3.75'
- Fence corner, West 3.7' ±

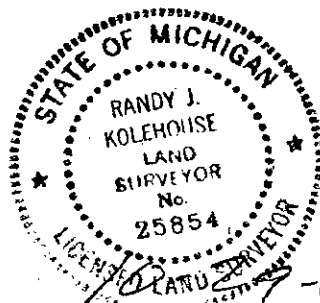

Signed by *[Signature]* Date _____

WILLIAMS & WORKS

Surveyor's Michigan License No. 25854