

MAY 22 2000

\$7.00  
\$2.00

SECTION

LAND CORNER RECORDATION CERTIFICATE  
Filing Requirement of Act 74, Mich. P.A. 1970  
KENT COUNTY REMONUMENTATION

For corners in

Kent (County)	Located in: Oakfield Township	Corner Code #
1. Public Land Survey	T 9N R 9W	K-5
	T R	
	T R	
	T R	
2. Property Controlling in Section	S T R	
	S T R	
3. Miscellaneous Property in Sec.	S T R	
	S T R	

STATE OF MICHIGAN  
COUNTY OF KENT  
RECEIVED FOR RECORD


1999 DEC - 8 AM 10:10

REG. OF DEEDS

11571

Register of Deeds Stamp & File Number

4. Lot No. \_\_\_\_\_, Recorded Plat \_\_\_\_\_
5. Private Claims \_\_\_\_\_

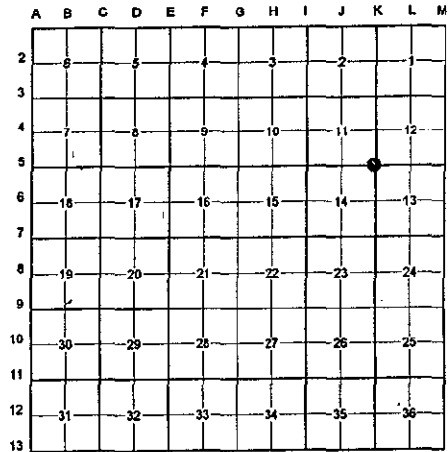

I, Randy Kolehouse, in a field survey on September 29 19 99, do hereby certify that under requirements of P.A. 74 Michigan P.A. of 1970, the corner points mentioned in lines 1 and 2 above were in conformance with regulations and rules therefore as required in the current manual of survey instructions of the United States Department of the interior, Bureau of Land Management or by a decree of a Court of Law and/or that the corner points mentioned in lines 3, 4 and 5 above were in conformance with the rules of the Michigan Board of Land Surveyors or by a Decree of a Court of Law; established, re-established, monumented, re-monumented, recovered, found as expressed below:

NOTE: Not more than 4 corners, all in the same town and range, may be recorded on this certificate.

A. Description of original monument and accessories and/or subsequent restoration:

K-5	1837	G.L.O. Notes	Cathcart	Set Post
	1946-63	Witness Map	K.C. Surveyor	1" Iron
	1984	L.C.R.C. #3723	All-Points Surveyors	1" Iron
	1985	L.C.R.C. #4152	Thomas Chettleburgh	Fnd. 1" Iron Pipe / Set K.C. Monument
	1994	L.C.R.C. #7238	Glaza & Associates	K.C. Monument

P.A. 345 1990 KENT COUNTY  
PEER APPROVED 10/28/99  
CHAIRMAN Harry Fisher

This corner was originally approved by the Kent County Remonumentation Peer Group and monumented by Thomas Chettleburgh on 4/2/85 and was recorded per L.C.R.C. #4152.

B. Description of corner evidence found and/or method applied in restoring or reestablishing corner:

K-5 Found a Standard Kent County Monument 1' ± South of a fence line running East and West per L.C.R.C.'s #4152 and #7238 as set by Thomas Chettleburgh in place of a 1" iron pipe he found which checked L.C.R.C. #3723 and the K.C. Surveyor's records.

L.C.R.C. #4152

Nail/tag in S side 16" Oak S86E 19.12'  
Nail/tag in SW side 20" Oak S60E 30.07'  
Nail/tag in W side 12" & 14" Oak S28E 15.82'

L.C.R.C. #7238


K.C. remon tag & nail in S side 18" Oak S86°E 19.15'  
K.C. remon tag & nail in SW side 20" Oak (stump) S60°E 30.07' (m. 30.10')  
K.C. remon tag & nail in W side 12" & 14" Oak (stump) S28°E 15.84' (m. 15.83')  
K.C. remon tag & nail in S side wood fence post N82°W 9.43' (m. 9.32')  
East-West wire fence N00°E 1.05'

The selected location is accepted by me and is generally accepted by professional surveyors as the best available evidence of the position of the original corner.

C. Description of monument for corner and accessories established to perpetuate locating the position of the corner:

K-5 Standard Kent County Monument

- ¼ Nail & K.C. remon. tag on S side 18" Oak S 86° E 19.15'
- Nail & K.C. remon. tag on SW side 20" stump S 60° E 30.10'
- Nail & K.C. remon. tag on W side 14" stump S 28° E 15.83'
- Nail & K.C. remon. tag on S side fence post N 82° W 9.32'
- Nail & K.C. remon. tag on E side 4" Oak North 23.96'
- Nail & K.C. remon. tag on W side 12" Oak S 25° E 56.30'
- Fence line running E-W, North 1' ±

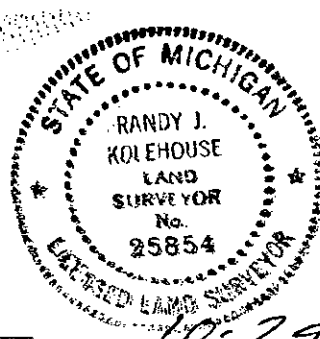

Signed by Randy J. Kolehouse Date 10-29-99

WILLIAMS & WORKS

Surveyor's Michigan License No. 25854