

\$7.00
\$2.00

SURVEY &
REMONUMENTATION

MAY 22 2000

LAND CORNER RECORDATION CERTIFICATE
Filing Requirement of Act 74, Mich. P.A. 1970
KENT COUNTY REMONUMENTATION

For comers in SECTION

Kent (County)	Located in:	Oakfield Township	Corner Code #
1. Public Land Survey	T <u>9N</u>	R <u>9W</u>	<u>K-9</u>
	T _____	R _____	_____
	T _____	R _____	_____
	T _____	R _____	_____
2. Property Controlling in Section	S _____	T _____	R _____
	S _____	T _____	R _____
3. Miscellaneous Property in Sec.	S _____	T _____	R _____
	S _____	T _____	R _____

STATE OF MICHIGAN
COUNTY OF KENT
RECEIVED FOR RECORD
1999 DEC 27 AM 8:19
REG. OF DEEDS

11655

Register of Deeds Stamp & File Number


- 4. Lot No. _____, Recorded Plat _____
- 5. Private Claims _____

I, Randy Kolehouse, in a field survey on March 25 19 99, do hereby certify that under requirements of P.A. 74 Michigan P.A. of 1970, the corner points mentioned in lines 1 and 2 above were in conformance with regulations and rules therefore as required in the current manual of survey instructions of the United States Department of the interior, Bureau of Land Management or by a decree of a Court of Law and/or that the corner points mentioned in lines 3, 4 and 5 above were in conformance with the rules of the Michigan Board of Land Surveyors or by a Decree of a Court of Law; established, re-established, monumented, re-monumented, recovered, found as expressed below:

NOTE: Not more than 4 corners, all in the same town and range, may be recorded on this certificate.

A. Description of original monument and accessories and/or subsequent restoration:

K-9	1837	G.L.O. Notes	Cathcart	Set Post
	N/A	Witness Map	K.C. Surveyor	Iron
	1973	L.C.R.C. #582	F.E. Spicer	1 1/2" Iron
	1981	L.C.R.C. #1861	Jonker Land Surveys	Fnd. 1-1/2" Iron / Set K.C. Monument
	1974	L.C.R.C. #7243	Glaza & Associates	K.C. Monument

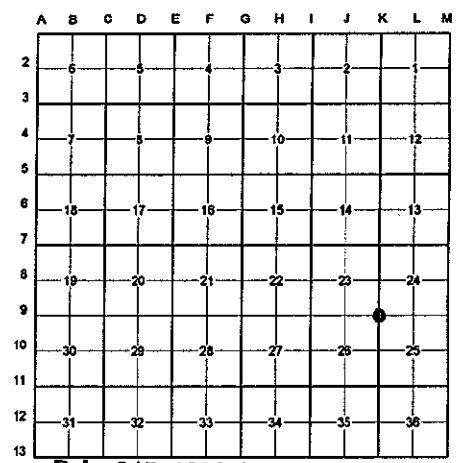

P.A. 345 1990 KENT COUNTY
PEER APPROVED 7/29/99
CHAIRMAN Harry Huber

This corner was originally approved by the Kent County Remonumentation Peer Group and monumented by Rob Jonker on 5/28/81 and was recorded per L.C.R.C. #1861.

B. Description of corner evidence found and/or method applied in restoring or reestablishing corner:

K-9 Found a Standard Kent County Monument on the C/L of Morgan Mills Avenue (bit.) extended South and 6' ± North of the C/L of 12 Mile Road (gravel) extended East per L.C.R.C.'s #1861 and #7243 as set by Rob Jonker in place of a 1-1/2" iron he found which checked L.C.R.C. #582 and the K.C. Surveyor's records.

L.C.R.C. #1861

L.C.R.C. #7243

Remon. tag on NE side 14" Hickory N45°W 74.42'
Remon. tag on S side 24" Oak N45°W 84.80'
Centerline gravel road N45 W 42'+/-

K.C. remon tag & nail in NE side 14" Hickory N45°W 74.37' (m. 74.42')
K.C. remon tag & nail in S side 24" Oak N45°W 84.85' (m. 84.87')
Centerline bit. road N45°W 39'+/-
K.C. remon tag & nail in E side 24" Oak N18°W 134.76' (m. 134.80')

The selected location is accepted by me and is generally accepted by professional surveyors as the best available evidence of the position of the original corner.

C. Description of monument for corner and accessories established to perpetuate locating the position of the corner:

- K-9 Standard Kent County Monument
- Nail & K.C. remon. tag on NE side 14" Hickory N 45° W 74.42'
 - Nail & K.C. remon. tag on S side 24" Oak N 70° W 84.87'
 - Nail & K.C. remon. tag on E side 24" Oak N 18° W 134.80'
 - Nail & K.C. remon. tag on N side 6" stump (4' high) S 84° E 43.28'
 - Nail & K.C. remon. tag on NW side 8" Oak S 40° W 31.42'
 - All Point capped iron East 32.78'



Signed by Randy J. Kolehouse Date _____

WILLIAMS & WORKS

Surveyor's Michigan License No. 25854