SURVEY & REMONUMENTATION

$7.00
$2.00

MAY 22 2000

SECTION

LAND CORNER RECORDATION CERTIFICATE
Filing Requirement of Act 74, Mich. P.A. 1970
KENT COUNTY REMONUMENTATION

STATE OF MICHIGAN
COUNTY OF KENT
RECEIVED FOR RECORD
1999 DEC 27 AM 8:19
REG. OF DEEDS

11656
Register of Deeds Stamp & File Number

For corners in Kent (County) Located in: Oakfield Township Corner Code #

1. Public Land Survey T 9N R 9W K-10
   T ____ R ____
   T ____ R ____
   T ____ R ____
2. Property Controlling in Section S ____ T ____ R ____
   S ____ T ____ R ____
3. Miscellaneous Property in Sec. S ____ T ____ R ____
   S ____ T ____ R ____

4. Lot No. ____, Recorded Plat ____
5. Private Claims ____

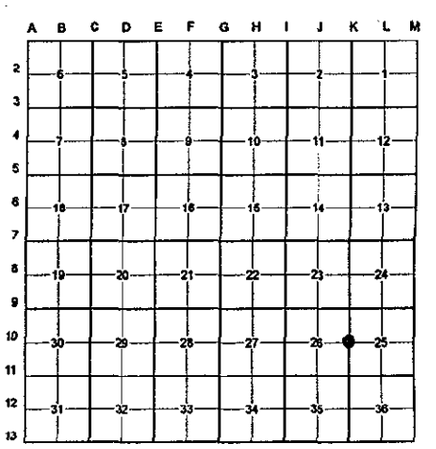

I, Randy Kolehouse, in a field survey on March 16 19 99, do hereby certify that under requirements of P.A. 74 Michigan P.A. of 1970, the corner points mentioned in lines 1 and 2 above were in conformance with regulations and rules therefore as required in the current manual of survey instructions of the United States Department of the interior, Bureau of Land Management or by a decree of a Court of Law and/or that the corner points mentioned in lines 3, 4 and 5 above were in conformance with the rules of the Michigan Board of Land Surveyors or by a Decree of a Court of Law; established, re-established, monumented, re-monumented, recovered, found as expressed below:

NOTE: ***Not more than 4 corners, all in the same town and range, may be recorded on this certificate.***

A. Description of original monument and accessories and/or subsequent restoration:

K-10	1837	G.L.O. Notes	Cathcart	Set Post
	1937	Witness Map	K.C. Surveyor	Iron
	1986	L.C.R.C. #4365	Williams & Works	Fnd. R.R. Spike, Iron & Conc. Mon. / Set K.C. Monument
	1994	L.C.R.C. #7244	Glaza & Associates	K.C. Monument

P.A. 345 1990 KENT COUNTY
PEER APPROVED 7/29/99
CHAIRMAN Nancy Huber

This corner was originally approved by the Kent County Remonumentation Peer Group and monumented by Randy Kolehouse on 11/2/85 and was recorded per L.C.R.C. #4365.

B. Description of corner evidence found and/or method applied in restoring or reestablishing corner:

K-10 Found a Standard Kent County Monument at the C/L intersection of Beardslee Road (bit.) running East and West and Ashley Avenue (gravel) running South per L.C.R.C.'s #4365 and #7244 as set by Randy Kolehouse in place of a railroad spike, iron and concrete monument he found which checked the K.C. Surveyor's records.

L.C.R.C. #4365

Nail & K.C. Remon. tag in N. side 30" maple S 75° E 122.75'
Nail & K.C. Remon. tag in W. side 12" Elm North 50.0'
Nail & K.C. Remon. tag in E. side P.Pole S 15° W 155.4'
P.K. & K.C. Remon. tag in Curb joint S 35° W 38.02'

L.C.R.C. #7244

Nail & K.C. remon tag in N side 38" Maple S75°E 122.72' (m. 122.68')
Nail & K.C. remon tag in E side P. pole S15°W 155.40' (m. 155.48')
P.K. & K.C. remon tag in curb joint S35°W 38.11' (m. 38.07')
Nail & K.C. remon tag in W side 24" Elm N00°E 51.45' (m. 51.42')

The selected location is accepted by me and is generally accepted by professional surveyors as the best available evidence of the position of the original corner.

C. Description of monument for corner and accessories established to perpetuate locating the position of the corner:

K-10 Standard Kent County Monument

Nail & K.C. remon. tag on N side 38" maple S 75° E 122.68'
Nail & K.C. remon. tag on E side P. pole S 15° W 155.48'
Nail & K.C. remon. tag on W side 24" Elm (dead) N 00° E 51.42'
P.K. in top curb joint S 35° W 38.07'
Nail & K.C. remon. tag on S side P. pole N 83° W 261.80'
On C/L of bit. road running E-W
On C/L of gravel road running S

STATE OF MICHIGAN
RANDY J. KOLEHOUSE
LAND SURVEYOR
No. 25854
LICENSED LAND SURVEYOR

Signed by Randy J Kolehouse Date 10-22-99
WILLIAMS & WORKS
Surveyor's Michigan License No. 25854

FORM APPROVED BY MICHIGAN STATE BOARD OF LAND SURVEYORS, JAN. 28, 1971
REVISED MAY 14, 1975
REVISED JAN., 1983