

\$7.00
\$2.00

MAY 22 2000

SECTION

LAND CORNER RECORDATION CERTIFICATE
Filing Requirement of Act 74, Mich. P.A. 1970
KENT COUNTY REMONUMENTATION

For corners in

Kent (County)	Located in: Oakfield Township	Corner Code #
1. Public Land Survey	T <u>9N</u> R <u>9W</u>	<u>K-11</u>
	T _____ R _____	_____
	T _____ R _____	_____
	T _____ R _____	_____
2. Property Controlling in Section	S _____ T _____ R _____	_____
	S _____ T _____ R _____	_____
3. Miscellaneous Property in Sec.	S _____ T _____ R _____	_____
	S _____ T _____ R _____	_____

REG. OF DEEDS

[Signature]

STATE OF MICHIGAN
COUNTY OF KENT
RECEIVED FOR RECORD
1999 DEC 27 AM 8:19

11657

Register of Deeds Stamp & File Number

4. Lot No. _____, Recorded Plat _____
5. Private Claims _____

I, Randy Kolehouse, in a field survey on March 26 19 99, do hereby certify that under requirements of P.A. 74 Michigan P.A. of 1970, the corner points mentioned in lines 1 and 2 above were in conformance with regulations and rules therefore as required in the current manual of survey instructions of the United States Department of the Interior, Bureau of Land Management or by a decree of a Court of Law and/or that the corner points mentioned in lines 3, 4 and 5 above were in conformance with the rules of the Michigan Board of Land Surveyors or by a Decree of a Court of Law; established, re-established, monumented, re-monumented, recovered, found as expressed below:

NOTE: Not more than 4 corners, all in the same town and range, may be recorded on this certificate.

A. Description of original monument and accessories and/or subsequent restoration:

K-11	1837	G.L.O. Notes	Cathcart	Set Post
	1978	L.C.R.C. #1159	C.S. Hay	Iron and Cap
	1981	L.C.R.C. #1863	Jonker Land Surveys	Fnd. Iron and Cap - Set K.C. Monument
	1994	L.C.R.C. #7245	Glaza & Associates	K.C. Monument

P.A. 345 1990 KENT COUNTY
PEER APPROVED 7/29/99
CHAIRMAN [Signature]

This corner was originally approved by the Kent County Remonumentation Peer Group and monumented by Rob Jonker on 5/28/81 and was recorded per L.C.R.C. #1863.

B. Description of corner evidence found and/or method applied in restoring or reestablishing corner:

K-11 Found a Standard Kent County Monument 9' ± South of the C/L of 11 Mile Road (gravel) running West and 7' ± West of Ashley Avenue (gravel) running North and South per L.C.R.C.'s #1863 and #7245 as set by Rob Jonker in place of an iron and cap he found which checked L.C.R.C. #1159.

L.C.R.C. #1863

L.C.R.C. #7245

Nail & remon. tag on W. side 30" Hickory S40°E. 53.5'
Nail & remon. tag on E. side 18" Cedar S40°W 63.65'
NE Cor. cone hse. fnd. S45°W 117.12'
Centerline "X" of gravel is 7'E & 11'N


K.C. remon tag & nail in W side 30" Hickory S40°E 53.48' (m. 53.46')
NE corner of concrete house foundation S45°W 117.12' (m. 116.98')
Centerline "X" of gravel is 7' E & S9' N
K.C. remon tag & nail in S side 12" Walnut N90°E 42.98' (m. 42.91')
K.C. remon tag & nail in SE side 24" Twin Cedar S40°W 62.88' (m. 62.7'±)
K.C. remon tag & nail in W side 8" Walnut N50°E 40.89' (m. 40.78')

The selected location is accepted by me and is generally accepted by professional surveyors as the best available evidence of the position of the original corner.

C. Description of monument for corner and accessories established to perpetuate locating the position of the corner:

K-11 Standard Kent County Monument

- Nail & K.C. remon. tag on W side 30" Hickory S 40° E 53.46'
- Nail & K.C. remon. tag on S side 12" Walnut N 90° E 42.91'
- Nail & K.C. remon. tag on W side 10" Walnut N 50° E 40.78'
- Nail & K.C. remon. tag on E side 10" Elm N 22° W 63.08'
- NE cor. hse. fndn. S 45° W 116.98'
- C/L of gravel road running W, North 9' ±
- C/L of gravel road running N-S, East 7' ±

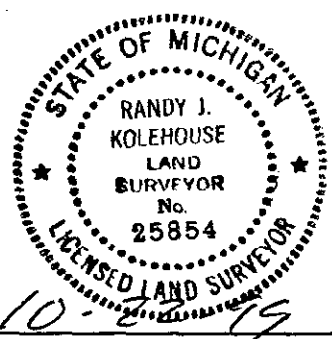

Signed by [Signature] Date 10-27-99

WILLIAMS & WORKS

Surveyor's Michigan License No. 25854