

MAY 22 2000

\$7.00
\$2.00

SECTION LAND CORNER RECORDATION CERTIFICATE
Filing Requirement of Act 74, Mich. P.A. 1970
KENT COUNTY REMONUMENTATION


For corners in Kent (County) Located in: Oakfield Township Corner Code #

1. Public Land Survey	T <u>9N</u>	R <u>9W</u>	<u>L-2</u>
	T	R	
	T	R	
	T	R	
2. Property Controlling in Section	S	T	R
	S	T	R
3. Miscellaneous Property in Sec.	S	T	R
	S	T	R

STATE OF MICHIGAN
COUNTY OF KENT
RECEIVED FOR RECORD
1999 DEC 27 AM 8:19
REG. OF DEEDS

11659
Register of Deeds Stamp & File Number

4. Lot No. _____, Recorded Plat _____
5. Private Claims _____

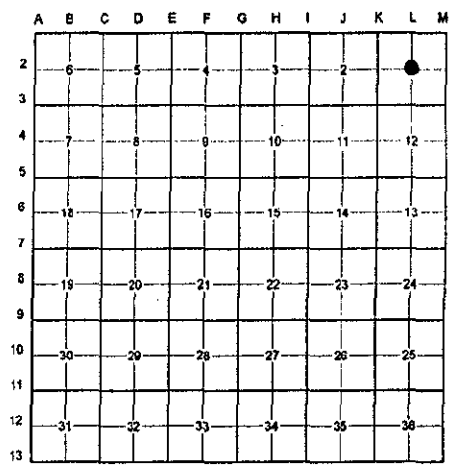

I, Randy Kolehouse, in a field survey on December 16 19 99, do hereby certify that under requirements of P.A. 74 Michigan P.A. of 1970, the corner points mentioned in lines 1 and 2 above were in conformance with regulations and rules therefore as required in the current manual of survey instructions of the United States Department of the interior, Bureau of Land Management or by a decree of a Court of Law and/or that the corner points mentioned in lines 3, 4 and 5 above were in conformance with the rules of the Michigan Board of Land Surveyors or by a Decree of a Court of Law, established, re-established, monumented, re-monumented, recovered, found as expressed below:

NOTE: Not more than 4 corners, all in the same town and range, may be recorded on this certificate.

A. Description of original monument and accessories and/or subsequent restoration:

L-2	This corner was not originally set by the G.L.O.
1938	Witness Map K.C. Surveyor Iron
1948-69	Survey Records Williams & Works Iron
1978	Survey Records Glaza Iron
1990	Survey Records Exxel Iron

P.A. 345 1990 KENT COUNTY
PEER APPROVED 12/02/99
CHAIRMAN [Signature]

B. Description of corner evidence found and/or method applied in restoring or reestablishing corner:

L-2 Found a 1" iron pipe per Kent County Witness Map (1938), Williams & Works Survey Records (1948-1969), Glaza Survey Records (1978) and Exxel Survey Records (1990) 20.0' West and 7.4' South of the intersection of 1/4 lines; also found iron set by All Points (1987) and used by Roosien (1990) at the approximate intersection of 1/4 lines. Due to the historical usage of the 1" iron pipe, it was decided to hold said iron as the Center of Section.

The selected location is accepted by me and is generally accepted by professional surveyors as the best available evidence of the position of the original corner.

C. Description of monument for corner and accessories established to perpetuate locating the position of the corner:

- L-2 Replaced 1" Iron Pipe with a Standard Kent County Monument
- Nail & K.C. remon. tag on NW side P. pole N 60° E 68.74'
- Nail & K.C. remon. tag on NE side P. pole S 40° E 73.96'
- Nail & K.C. remon. tag on SE side P. pole S 45° W 80.75'
- Nail & K.C. remon. tag on E side 8" Apple N 20° W 58.10'
- Exxel capped iron in concrete South 33.03'
- 3/4" iron pipe North 33.04'
- Rebar 20.0' E and 7.4' N M/L



Signed by [Signature] Date 12-20-99
WILLIAMS & WORKS
Surveyor's Michigan License No. 25854