

MAY 22 2000

\$7.00
\$2.00

SECTION

LAND CORNER RECORDATION CERTIFICATE
Filing Requirement of Act 74, Mich. P.A. 1970
KENT COUNTY REMONUMENTATION

For corners in

Kent (County)	Located in: Oakfield Township	Corner Code #
1. Public Land Survey	T <u>9N</u> R <u>9W</u>	<u>L-3</u>
	T _____ R _____	_____
	T _____ R _____	_____
	T _____ R _____	_____
2. Property Controlling in Section	S _____ T _____ R _____	_____
	S _____ T _____ R _____	_____
3. Miscellaneous Property in Sec.	S _____ T _____ R _____	_____
	S _____ T _____ R _____	_____
4. Lot No. _____, Recorded Plat _____		
5. Private Claims _____		


REG. OF DEEDS
1999 DEC 27 AM 8:19
STATE OF MICHIGAN
COUNTY OF KENT
RECEIVED FOR RECORD
11660
Register of Deeds Stamp & File Number

I, Randy Kolehouse, in a field survey on February 24 19 99, do hereby certify that under requirements of P.A. 74 Michigan P.A. of 1970, the corner points mentioned in lines 1 and 2 above were in conformance with regulations and rules therefore as required in the current manual of survey instructions of the United States Department of the interior, Bureau of Land Management or by a decree of a Court of Law and/or that the corner points mentioned in lines 3, 4 and 5 above were in conformance with the rules of the Michigan Board of Land Surveyors or by a Decree of a Court of Law; established, re-established, monumented, re-monumented, recovered, found as expressed below:

NOTE: Not more than 4 corners, all in the same town and range, may be recorded on this certificate.

A. Description of original monument and accessories and/or subsequent restoration:

L-3	1837	G.L.O. Notes	Cathcart	Set Post
	1989	L.C.R.C. #5162	John Bueche	Set K.C. Monument
	1994	L.C.R.C. #7249	Glaza & Associates	K.C. Monument

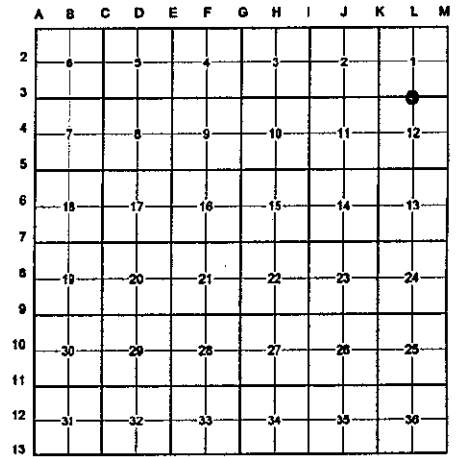

P.A. 345 1990 KENT COUNTY
PEER APPROVED 7/29/99
CHAIRMAN Randy Heber

This corner was originally approved by the Kent County Remonumentation Peer Group and monumented by John Bueche on 6/15/89 and was recorded per L.C.R.C. #5162.

B. Description of corner evidence found and/or method applied in restoring or reestablishing corner:

L-3 Found a Standard Kent County Monument 1' North of a fence line and tree row running East and West per L.C.R.C.'s #5162 and #7249 as set by John Bueche.

L.C.R.C. #5162

Nail & Remon. Tag in NW side Tri. 16" Oak S 75° W 12.30'
Nail & Remon. Tag in SE side 12" Oak S 40° W 4.92'
Nail & Remon. Tag in NW side 8" Oak N 36° E 20.39'
Nail & Remon. Tag in SW side 24" Oak S 60° E 12.74'
40d nail in SE side fence post SW 0.95'
On old fence & tree row E-W

L.C.R.C. #7249


Nail & K.C. remon tag in NW side 16" Triple Oak S75°W 12.25' (m. 12.30')
Nail & K.C. remon tag in SE side 14" Oak S40°W 4.82' (m. 4.88')
Nail & K.C. remon tag in NW side 10" Oak N36°E 20.49' (m. 20.38')
Nail & K.C. remon tag in SW side 24" Oak S60°E 12.67'
40d nail in SE side fence post SW 0.95' (m. 0.97')
On old fence row 1'+- South

The selected location is accepted by me and is generally accepted by professional surveyors as the best available evidence of the position of the original corner.

C. Description of monument for corner and accessories established to perpetuate locating the position of the corner:

L-3 Standard Kent County Monument

Nail & K.C. remon. tag on NW side 16" triple Oak S 75° W 12.30'
Nail & K.C. remon. tag on SE side 14" Oak S 40° W 4.88'
Nail & K.C. remon. tag on NW side 10" Oak N 36° E 20.38'
Nail & K.C. remon. tag on SW side 24" Oak S 60° E 12.67'
40d Nail SE side fence post Southwest 0.97'
On fence line and tree row running E-W

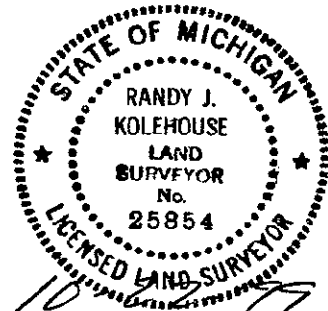

Signed by Randy J. Kolehouse Date _____

WILLIAMS & WORKS

Surveyor's Michigan License No. 25854