

MAY 22 2000

\$7.00  
\$2.00

SECTION

LAND CORNER RECORDATION CERTIFICATE  
Filing Requirement of Act 74, Mich. P.A. 1970  
KENT COUNTY REMONUMENTATION

For corners in

Kent (County)	Located in: Oakfield Township	Corner Code #
1. Public Land Survey	T 9N R 9W	L-6
	T R	
	T R	
	T R	
2. Property Controlling in Section	S T R	
	S T R	
3. Miscellaneous Property in Sec.	S T R	
	S T R	

REG. OF DEEDS

*[Signature]*

STATE OF MICHIGAN  
COUNTY OF KENT  
RECEIVED FOR RECORD  
1999 DEC 27 AM 8:19

11662

Register of Deeds Stamp & File Number

- 4. Lot No. \_\_\_\_\_, Recorded Plat \_\_\_\_\_
- 5. Private Claims \_\_\_\_\_

I, Randy Kolehouse, in a field survey on March 16 19 99, do hereby certify that under requirements of P.A. 74 Michigan P.A. of 1970, the corner points mentioned in lines 1 and 2 above were in conformance with regulations and rules therefore as required in the current manual of survey instructions of the United States Department of the interior, Bureau of Land Management or by a decree of a Court of Law and/or that the corner points mentioned in lines 3, 4 and 5 above were in conformance with the rules of the Michigan Board of Land Surveyors or by a Decree of a Court of Law; established, re-established, monumented, re-monumented, recovered, found as expressed below:


**NOTE: Not more than 4 corners, all in the same town and range, may be recorded on this certificate.**

A. Description of original monument and accessories and/or subsequent restoration:

L-6 This corner was not originally set by the G.L.O.

1958	Survey Records	Williams & Works	Hold Calc. Intersection of 1/4 Lines
1990	Survey Records	Exxel	3/8" Iron

P.A. 345 1990 KENT COUNTY  
PEER APPROVED 12/02/99  
CHAIRMAN [Signature]

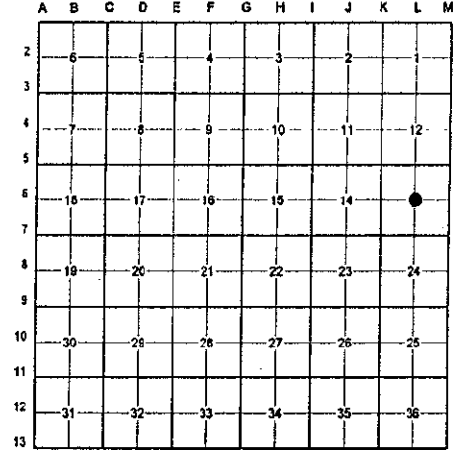

B. Description of corner evidence found and/or method applied in restoring or reestablishing corner:

L-6 Found a 3/8" iron which checks survey information from a 1990 Exxel survey. The found iron is 3' ± North and 3' ± West from the intersection of 1/4 lines. Held the found 3/8" iron for the Center of Section.

Survey Records (1990)


- Nail SW sde 14" Beech SE 26.38' (m. 26.73')
- Nail N sde 18" Beech WSW 59.20' (m. 59.5')
- Nail S sde 10" Beech West 29.60' (m. 29.45')
- Nail W sde 12" W. Cherry 6.46' (m. 6.25')

The selected location is accepted by me and is generally accepted by professional surveyors as the best available evidence of the position of the original corner.

C. Description of monument for corner and accessories established to perpetuate locating the position of the corner:

L-6 Replaced 3/8" Iron with a Standard Kent County Monument

- Nail & K.C. remon. tag on SW side 15" Beech S 50° E 26.73'
- Nail & K.C. remon. tag on NW side 12" Beech S 15° W 24.66'
- Nail & K.C. remon. tag on S side 12" Beech N 80° W 29.45'
- Nail & K.C. remon. tag on W side 14" Cherry N 25° W 6.25'
- Nail & K.C. remon. tag on S side 6" Elm N 90° E 9.03'

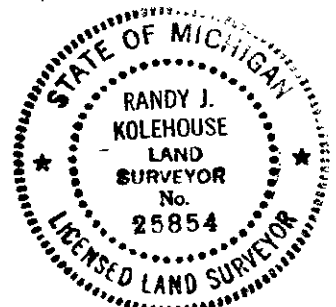

Signed by [Signature]  
WILLIAMS & WORKS

Date 12-20-99

Surveyor's Michigan License No. 25854