

MAY 22 2000

\$7.00
\$2.00

SECTION

LAND CORNER RECORDATION CERTIFICATE
Filing Requirement of Act 74, Mich. P.A. 1970
KENT COUNTY REMONUMENTATION

For corners in

Kent (County)	Located in: Oakfield Township	Corner Code #
1. Public Land Survey	T 9N R 9W	L-8
	T R	
	T R	
	T R	
2. Property Controlling in Section	S T R	
	S T R	
3. Miscellaneous Property in Sec.	S T R	
	S T R	
4. Lot No. _____, Recorded Plat _____		
5. Private Claims _____		


STATE OF MICHIGAN
COUNTY OF KENT
RECEIVED FOR RECORD
1999 DEC 27 AM 8:20
REG. OF DEEDS

11664

Register of Deeds Stamp & File Number

I, Randy Kolehouse, in a field survey on December 16 19 99, do hereby certify that under requirements of P.A. 74 Michigan P.A. of 1970, the corner points mentioned in lines 1 and 2 above were in conformance with regulations and rules therefore as required in the current manual of survey instructions of the United States Department of the interior, Bureau of Land Management or by a decree of a Court of Law and/or that the corner points mentioned in lines 3, 4 and 5 above were in conformance with the rules of the Michigan Board of Land Surveyors or by a Decree of a Court of Law; established, re-established, monumented, re-monumented, recovered, found as expressed below:

NOTE: Not more than 4 corners, all in the same town and range, may be recorded on this certificate.

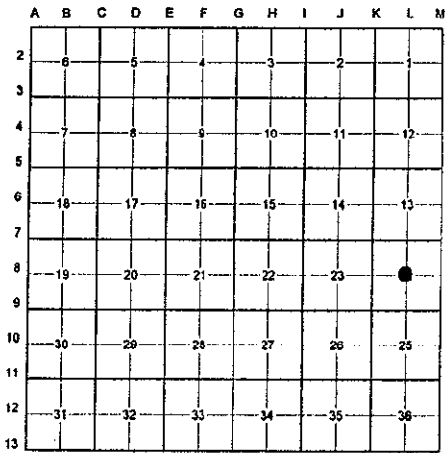

A. Description of original monument and accessories and/or subsequent restoration:

L-8	This corner was not originally set by the G.L.O.
N/A	Witness Map
1913	Survey Records
1984	L.C.R.C. #4209
K.C. Surveyor	Williams & Works
Iron	Set Center
	"T" Iron

P.A. 345 1990 KENT COUNTY
PEER APPROVED 12/16/99
CHAIRMAN Randy Kolehouse

B. Description of corner evidence found and/or method applied in restoring or reestablishing corner:

L-8 Found an All-Points Survey iron which checks witnesses from L.C.R.C. #4209 (Williams & Works "T" iron had been removed). Per L.C.R.C. #4209, this point was set at the intersection of 1/4 lines and was set to correct an error in the 1913 Center Section (1913 corner is 74' East and 9' South). The capped rebar is 0.4' South of the intersection of 1/4 lines. Held as the Center of Section.

L.C.R.C. #4209

- Nail in N.side 10" Oak S.80°W. 13.98' (m. 14.02')
- Nail in NE side 20" Pine N.35°W. 64.43' (m. 64.42')
- Nail in W.side 18" Oak N.30°E. 26.60' (m. 26.69')
- Nail in S.side 16" Oak S.70°E. 21.40' (m. 21.34')
- Iron S.82°E. 74.35' (m. 73.90')

The selected location is accepted by me and is generally accepted by professional surveyors as the best available evidence of the position of the original corner.

C. Description of monument for corner and accessories established to perpetuate locating the position of the corner:

L-8 Replaced Capped Rebar with a Standard Kent County Monument

- Nail & K.C. remon. tag on N side 14" Oak S 80° W 14.02'
- Nail & K.C. remon. tag on NE side 24" Pine N 35° W 64.42'
- Nail & K.C. remon. tag on W side 22" Oak N 30° E 26.69'
- Nail & K.C. remon. tag on S side 18" Oak S 70° E 21.34'
- Nail & K.C. remon. tag on W side 15" Pine S 25° W 29.27'
- All Points iron S 82° E 73.90'



Signed by Randy J. Kolehouse Date 12-20-99
WILLIAMS & WORKS

Surveyor's Michigan License No. 25854