

\$7.00
\$2.00

MAY 22 2000

LAND CORNER RECORDATION CERTIFICATE
Filing Requirement of Act 74, Mich. P.A. 1970
KENT COUNTY REMONUMENTATION

SECTION

For corners in

Kent (County)	Located in:	Oakfield Township	Corner Code #
1. Public Land Survey	T <u>9N</u>	R <u>9W</u>	<u>L-9</u>
	T _____	R _____	_____
	T _____	R _____	_____
	T _____	R _____	_____
2. Property Controlling in Section	S _____	T _____	R _____
	S _____	T _____	R _____
3. Miscellaneous Property in Sec.	S _____	T _____	R _____
	S _____	T _____	R _____

REG. OF DEEDS

[Signature]

STATE OF MICHIGAN
COUNTY OF KENT
RECEIVED FOR RECORD
1999 DEC - 8 AM 10:10

11575

Register of Deeds Stamp & File Number

- 4. Lot No. _____, Recorded Plat _____
- 5. Private Claims _____

	A	B	C	D	E	F	G	H	I	J	K	L	M
2													
3													
I, Randy Kolehouse, in a field survey on September 29 19 99, do hereby certify that under requirements of P.A. 74 Michigan P.A. of 1970, the corner points mentioned in lines 1 and 2 above were in conformance with regulations and rules therefore as required in the current manual of survey instructions of the United States Department of the interior, Bureau of Land Management or by a decree of a Court of Law and/or that the corner points mentioned in lines 3, 4 and 5 above were in conformance with the rules of the Michigan Board of Land Surveyors or by a Decree of a Court of Law; established, re-established, monumented, re-monumented, recovered, found as expressed below:

NOTE: Not more than 4 corners, all in the same town and range, may be recorded on this certificate.

A. Description of original monument and accessories and/or subsequent restoration:

L-9	1837	G.L.O. Notes	Cathcart	Set Post
	1983	L.C.R.C. #3336	Glaza & Associates	N/A
	N/A	Survey	William Byl	"T" Iron
	1984	L.C.R.C. #3733	Williams & Works	Fnd. "T" Iron / Set K.C. Monument
	1994	L.C.R.C. #7252	Glaza & Associates	K.C. Monument

P.A. 345 1990 KENT COUNTY
PEER APPROVED 10/29/99
CHAIRMAN [Signature]

This corner was originally approved by the Kent County Remonumentation Peer Group and monumented by Williams & Works on 2/1/84 and was recorded per L.C.R.C. #3733.

B. Description of corner evidence found and/or method applied in restoring or reestablishing corner:

- L-9 Found a Standard Kent County Monument on line of a downed fence line running North and South per L.C.R.C.'s #3733 and #7252 as set by Williams & Works in place of a "T" iron they found which checked a survey by William Byl and L.C.R.C. #3336.

L.C.R.C. #3733

L.C.R.C. #7252

Nail & KC Remon. tag in N. face 16" Maple S.50°W. 27.44'
 Nail & KC Remon. tag in NE face 8" Maple N.80°W. 32.73'
 Nail & KC Remon. tag in SW face 8" Maple N.50°W. 18.12'
 Nail & KC Remon. tag in W. face 4" Pine N.15°E. 24.33'
 Nail & KC Remon. tag in W. face 16" Maple N.32°E. 42.62'
 Nail & KC Remon. tag in W. face 14" Maple stump (5'+/- high)
 South 44.48'


Nail & K.C. remon tag in N side 16" Maple N80°W 27.35' (m. 27.48')
 Nail & K.C. remon tag in NE side 12" Maple N60°W 32.68' (m. 32.86')
 Nail & K.C. remon tag in SW side 12" Maple N40°W 18.09' (m. 18.08')
 Nail & K.C. remon tag in W side 10" Pine N30°E 24.50'
 Nail & K.C. remon tag in W side 24" Maple N40°E 42.31' (m. 42.36')

The selected location is accepted by me and is generally accepted by professional surveyors as the best available evidence of the position of the original corner.

C. Description of monument for corner and accessories established to perpetuate locating the position of the corner:

- L-9 Standard Kent County Monument

Nail & K.C. remon. tag on N side 18" Maple N 80° W 27.48'
 Nail & K.C. remon. tag on NE side 12" Maple N 60° W 32.86'
 Nail & K.C. remon. tag on SW side 12" Maple N 40° W 18.08'
 Nail & K.C. remon. tag on W side 10" Pine N 30° E 24.50'
 Nail & K.C. remon. tag on W side 24" Maple N 40° E 42.36'
 On downed fence line running N-S

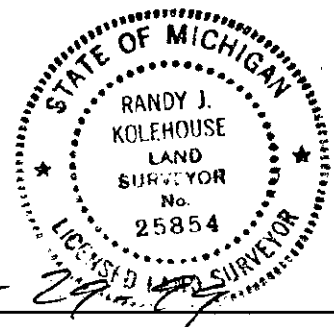

Signed by [Signature] Date 10-29-99
 WILLIAMS & WORKS
 Surveyor's Michigan License No. 25854