

\$7.00
\$2.00

MAY 22 2000

SECTION

LAND CORNER RECORDATION CERTIFICATE
Filing Requirement of Act 74, Mich. P.A. 1970
KENT COUNTY REMONUMENTATION

For corners in

Kent (County)	Located in: Oakfield Township	Corner Code #
1. Public Land Survey	T <u>9N</u> R <u>9W</u>	<u>L-10</u>
	T _____ R _____	_____
	T _____ R _____	_____
	T _____ R _____	_____
2. Property Controlling in Section	S _____ T _____ R _____	_____
	S _____ T _____ R _____	_____
3. Miscellaneous Property in Sec.	S _____ T _____ R _____	_____
	S _____ T _____ R _____	_____

REG. OF DEEDS

[Signature]

STATE OF MICHIGAN
COUNTY OF KENT
RECEIVED FOR RECORD
1999 DEC 27 AM 8:20

11665

Register of Deeds Stamp & File Number


- 4. Lot No. _____, Recorded Plat _____
- 5. Private Claims _____

I, Randy Kolehouse, in a field survey on December 14 19 99, do hereby certify that under requirements of P.A. 74 Michigan P.A. of 1970, the corner points mentioned in lines 1 and 2 above were in conformance with regulations and rules therefore as required in the current manual of survey instructions of the United States Department of the interior, Bureau of Land Management or by a decree of a Court of Law and/or that the corner points mentioned in lines 3, 4 and 5 above were in conformance with the rules of the Michigan Board of Land Surveyors or by a Decree of a Court of Law; established, re-established, monumented, re-monumented, recovered, found as expressed below:

NOTE: Not more than 4 corners, all in the same town and range, may be recorded on this certificate.

A. Description of original monument and accessories and/or subsequent restoration:

L-10 This corner was not originally set by the G.L.O.
1937 Witness Map K.C. Surveyor Iron

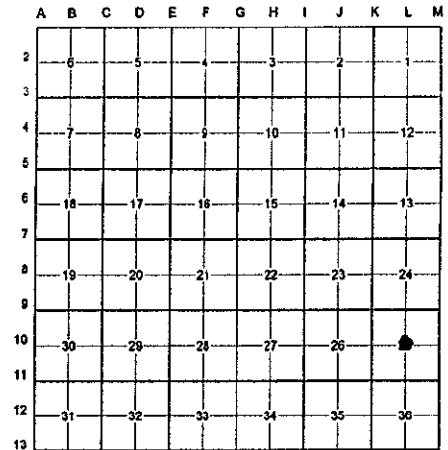

P.A. 345 1990 KENT COUNTY

PEER APPROVED 12/02/99

CHAIRMAN *[Signature]*


B. Description of corner evidence found and/or method applied in restoring or reestablishing corner:

L-10 Did not find the iron nor witnesses shown on the K.C. Witness Map (1937). Set point at the intersection of 1/4 lines. Said point falls in the C/L of Beardslee Street (bit.) running East and West, 1' East of fence line running South, for the Center of Section. (Found PK nails 5.3' West and 7.9' West used by Fricke in 1997.)

The selected location is accepted by me and is generally accepted by professional surveyors as the best available evidence of the position of the original corner.

C. Description of monument for corner and accessories established to perpetuate locating the position of the corner:

L-10 Set a Standard Kent County Monument
Nail & K.C. remon. tag on W side 10" Elm N 20° E 24.64'
Nail & K.C. remon. tag on SW side 10" Elm N 45° W 31.60'
Nail & K.C. remon. tag on SE side 32" Oak S 50° W 78.82'
Nail & K.C. remon. tag on W side 30" Willow S 05° W 69.99'
Nail & K.C. remon. tag on S side 12" Oak N 80° E 87.67'
On C/L of bit. road running E-W
Fence line running S, West 1'

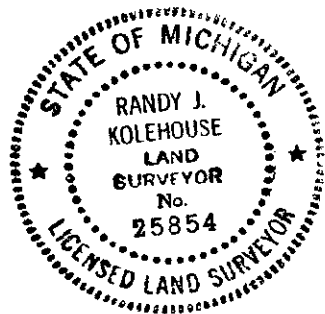

Signed by *[Signature]*

Date 12-20-99

WILLIAMS & WORKS

Surveyor's Michigan License No. 25854