

MAY 22 2000

\$7.00  
\$2.00

SECTION

LAND CORNER RECORDATION CERTIFICATE  
Filing Requirement of Act 74, Mich. P.A. 1970  
KENT COUNTY REMONUMENTATION

For corners in

Kent (County)	Located in: Oakfield Township	Corner Code #
1. Public Land Survey	T <u>9N</u> R <u>9W</u>	<u>L-11</u>
	T _____ R _____	_____
	T _____ R _____	_____
	T _____ R _____	_____
2. Property Controlling in Section	S _____ T _____ R _____	_____
	S _____ T _____ R _____	_____
3. Miscellaneous Property in Sec.	S _____ T _____ R _____	_____
	S _____ T _____ R _____	_____
4. Lot No. _____, Recorded Plat _____		
5. Private Claims _____		

REG. OF DEEDS

*[Signature]*

STATE OF MICHIGAN  
COUNTY OF KENT  
RECEIVED FOR RECORD  
1999 DEC 27 AM 8:20

11666

Register of Deeds Stamp & File Number

I, Randy Kolehouse, in a field survey on March 16 19 99, do hereby certify that under requirements of P.A. 74 Michigan P.A. of 1970, the corner points mentioned in lines 1 and 2 above were in conformance with regulations and rules therefore as required in the current manual of survey instructions of the United States Department of the interior, Bureau of Land Management or by a decree of a Court of Law and/or that the corner points mentioned in lines 3, 4 and 5 above were in conformance with the rules of the Michigan Board of Land Surveyors or by a Decree of a Court of Law; established, re-established, monumented, re-monumented, recovered, found as expressed below:

NOTE: Not more than 4 corners, all in the same town and range, may be recorded on this certificate.

	A	B	C	D	E	F	G	H	I	J	K	L	M
2	5	6	7	8	9	10	11	12	13	14	15	16	17
3													
4	7	8	9	10	11	12	13	14	15	16	17	18	19
5													
6	18	17	16	15	14	13	12	11	10	9	8	7	6
7													
8	19	20	21	22	23	24	25	26	27	28	29	30	31
9													
10	30	29	28	27	26	25	24	23	22	21	20	19	18
11													
12	31	32	33	34	35	36	37	38	39	40	41	42	43
13													

A. Description of original monument and accessories and/or subsequent restoration:

L-11	1837	G.L.O. Notes	Cathcart	Set Post
	1991	L.C.R.C. #5747	Thomas Chettleburgh	Set K.C. Monument
	1994	L.C.R.C. #7253	Glaza & Associates	K.C. Monument

P.A. 345 1990 KENT COUNTY  
PEER APPROVED 7/29/99  
CHAIRMAN *[Signature]*

This corner was originally approved by the Kent County Remonumentation Peer Group and monumented by Thomas Chettleburgh on 2/13/91 and was recorded per L.C.R.C. #5747.

B. Description of corner evidence found and/or method applied in restoring or reestablishing corner:

L-11 Found a Standard Kent County Monument 4" above ground 3' ± West of a fence line running North and South and 200' ± South of a fence line running East and West per L.C.R.C.'s #5747 and #7253 as set by Thomas Chettleburgh.

L.C.R.C. #5747

L.C.R.C. #7253

Iron Pipe in W. root of 29" Oak North 200.83'  
KC Remon tag in NW side of 17" Oak N46°E 45.50'  
KC Remon tag in S. side of 12" Beech S69°E 72.33'  
KC Remon tag in E. side of 7" Maple S30°W 13.02'


Iron pipe in West root of 29" Oak North 200.83' (m. 201.00')  
K.C. remon tag & nail in NW side 17" Oak N46°E 45.50' (m. 45.57')  
K.C. remon tag & nail in S side 14" Beech S69°E 72.33' (m. 72.50')  
K.C. remon tag & nail in E side 8" Maple S30°W 13.02' (m. 13.05')

The selected location is accepted by me and is generally accepted by professional surveyors as the best available evidence of the position of the original corner.

C. Description of monument for corner and accessories established to perpetuate locating the position of the corner:

L-11 Standard Kent County Monument

Iron pipe in West root of 29" Oak North 201.00'  
Nail & K.C. remon. tag on NW side 17" Oak N 46° E 45.57'  
Nail & K.C. remon. tag on S side 14" Beech S 69° E 72.50'  
Nail & K.C. remon. tag on E side 8" Maple S 30° W 13.05'  
Fence line running N-S, East 3' ±  
Fence line running E-W, North 200' ±

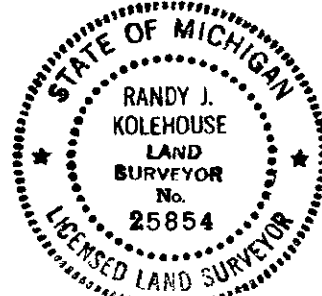

Signed by *[Signature]* Date 10-22-99

WILLIAMS & WORKS

Surveyor's Michigan License No. 25854