

\$7.00
\$2.00

MAR 08 1999

LAND CORNER RECORDATION CERTIFICATE
Filing Requirement of Act 74, Mich. P.A. 1970
KENT COUNTY REMONUMENTATION

SECTION

For corners in

| Kent (County) | Located in: | Oakfield Township | Corner Code # |
|---------------------------------------|-------------|----------------------|---------------|
| 1. Public Land Survey | T <u>9N</u> | R <u>9W</u> | <u>L-13</u> |
| | T _____ | R _____ | _____ |
| | T _____ | R _____ | _____ |
| | T _____ | R _____ | _____ |
| 2. Property Controlling in Section | S _____ | T _____ | R _____ |
| | S _____ | T _____ | R _____ |
| 3. Miscellaneous Property in Sec. | S _____ | T _____ | R _____ |
| | S _____ | T _____ | R _____ |

STATE OF MICHIGAN
 COUNTY OF KENT
 RECEIVED FOR RECORD
 98 DEC 14 AM 8:00
 REG. OF DEEDS
Lucy St. Paul

10960

Register of Deeds Stamp & File Number

4. Lot No. _____, Recorded Plat _____
 5. Private Claims _____

| | A | B | C | D | E | F | G | H | I | J | K | L | M |
|----|----|---|----|---|----|---|----|---|----|---|----|---|---|
| 2 | 6 | | 5 | | 4 | | 3 | | 2 | | 1 | | |
| 3 | | | | | | | | | | | | | |
| 4 | 7 | | 8 | | 9 | | 10 | | 11 | | 12 | | |
| 5 | | | | | | | | | | | | | |
| 6 | 18 | | 17 | | 16 | | 15 | | 14 | | 13 | | |
| 7 | | | | | | | | | | | | | |
| 8 | 19 | | 20 | | 21 | | 22 | | 23 | | 24 | | |
| 9 | | | | | | | | | | | | | |
| 10 | 30 | | 29 | | 28 | | 27 | | 26 | | 25 | | |
| 11 | | | | | | | | | | | | | |
| 12 | 31 | | 32 | | 33 | | 34 | | 35 | | 36 | | |
| 13 | | | | | | | | | | | | | |

I, Randy Kolehouse, in a field survey on January 30 19 98, do hereby certify that under requirements of P.A. 74 Michigan P.A. of 1970, the corner points mentioned in lines 1 and 2 above were in conformance with regulations and rules therefore as required in the current manual of survey instructions of the United States Department of the Interior, Bureau of Land Management or by a decree of a Court of Law and/or that the corner points mentioned in lines 3, 4 and 5 above were in conformance with the rules of the Michigan Board of Land Surveyors or by a Decree of a Court of Law; established, re-established, monumented, re-monumented, recovered, found as expressed below:

NOTE: Not more than 4 corners, all in the same town and range, may be recorded on this certificate.

| A. | Description of original monument and accessories and/or subsequent restoration: |
|------|---|
| L-13 | 1837 G.L.O. Notes N. Brookfield Set Post 1985 L.C.R.C. #4268 William Byl Set K.C. Monument 1994 L.C.R.C. #7254 Glaza & Associates K.C. Monument |

P.A. 345 1990 KENT COUNTY
 PEER APPROVED 1/24/98
 CHAIRMAN Harry Huber


Note: This corner is not common with L-1, T8N, R9W.

This corner was originally approved by the Kent County Remonumentation Peer Group and monumented by William Byl on 7/1/85 and was recorded per L.C.R.C. #4268.

| B. | Description of corner evidence found and/or method applied in restoring or reestablishing corner: | | | | | | | | | | | | | | | | |
|--|--|----------------|----------------|--|---|---|---|--|--|--|--|---|--|--|---|--|------------------------------|
| L-13 | Found a Standard Kent County Monument on the C/L of 10 Mile Road (gravel) running East and West per L.C.R.C.'s #4268 and #7254 as set by William Byl midway and on a straight line between the Southeast and Southwest corners of Section 36. | | | | | | | | | | | | | | | | |
| | <table border="0"> <tr> <td style="text-align: center;">L.C.R.C. #4268</td> <td style="text-align: center;">L.C.R.C. #7254</td> </tr> <tr> <td>NE cor. fdn. of garage, Hse #14010 S 30° E 131.12'</td> <td>NE corner foundation of garage, house #14010 S 30° E 131.18' (m. 131.12')</td> </tr> <tr> <td>NW cor. fdn. Hse #14010 S 10° W 111.98'</td> <td>NW corner foundation of house #14010 S 10° W 112.07' (m. 111.99')</td> </tr> <tr> <td>Nail & tag, E sd. 36" Maple N 45° E 40.67'</td> <td>Nail & K.C. remon tag in E side 36" Maple N 45° E 40.70'</td> </tr> <tr> <td>Nail & tag, E sd. 24" Oak N 10° W 49.47'</td> <td>Nail & K.C. remon tag in E side 24" Oak N 10° W 49.51' (m. 49.49')</td> </tr> <tr> <td>Nail & tag, E sd. Power pole N 25° W 69.95'</td> <td>Nail & K.C. remon tag in E side P. pole N 25° W 69.95' (m. 69.92')</td> </tr> <tr> <td>Kent County Monument @ N 1/4 cor. Sec. 1, T8N, R9W S 90° W</td> <td>Kent Co Mon @ N 1/4 cor, Sec 1, T8N, R9W S 90° W 34.98'</td> </tr> <tr> <td></td> <td>In C/L East-West gravel road</td> </tr>

The selected location is accepted by me and is generally accepted by professional surveyors as the best available evidence of the position of the original corner.

| C. | Description of monument for corner and accessories established to perpetuate locating the position of the corner: |
|------|---|
| L-13 | Standard Kent County Monument Nail & K.C. remon. tag on E side 36" Maple N 45° E 40.70' Nail & K.C. remon. tag on E side 24" Oak N 10° W 49.49' Nail & K.C. remon. tag on E side P. pole N 25° W 69.92' NE cor. fdn. of garage, house #14010 S 30° E 131.12' NW cor. fdn. of house #14010 S 10° W 111.99' On C/L of gravel road running E-W K.C. Mon., L-1, T8N, R9W, S 90° W 34.98' |

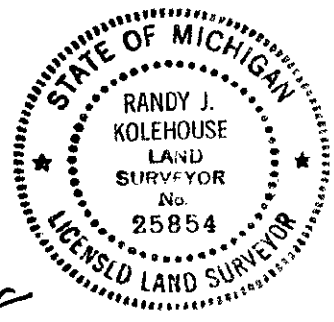

Signed by Randy J. Kolehouse Date 11/18/98
 EARTH TECH
 Surveyor's Michigan License No. 25854