

MAY 22 2000

\$7.00  
\$2.00

SECTION

LAND CORNER RECORDATION CERTIFICATE  
Filing Requirement of Act 74, Mich. P.A. 1970  
KENT COUNTY REMONUMENTATION

For corners in

Kent (County)	Located in: Oakfield Township	Corner Code #
1. Public Land Survey	T <u>9N</u> R <u>9W</u>	<u>M-4</u>
	T _____ R _____	_____
	T _____ R _____	_____
	T _____ R _____	_____
2. Property Controlling in Section	S _____ T _____ R _____	_____
	S _____ T _____ R _____	_____
3. Miscellaneous Property in Sec.	S _____ T _____ R _____	_____
	S _____ T _____ R _____	_____

REG. OF DEEDS

*[Signature]*

STATE OF MICHIGAN  
COUNTY OF KENT  
RECEIVED FOR RECORD  
1999 DEC - 8 AM 10:10

11579

Register of Deeds Stamp & File Number

- 4. Lot No. \_\_\_\_\_, Recorded Plat \_\_\_\_\_
- 5. Private Claims \_\_\_\_\_

	A	B	C	D	E	F	G	H	I	J	K	L	M
2	6	5	4	3	2	1							
3													
4	7	6	5	4	3	2	1						
5													
6	16	17	16	15	14	13							
7													
8	18	20	21	22	23	24							
9													
10	30	29	28	27	26	25							
11													
12	31	32	33	34	35	36							
13													

I, Randy Kolehouse, in a field survey on September 20 19 99, do hereby certify that under requirements of P.A. 74 Michigan P.A. of 1970, the corner points mentioned in lines 1 and 2 above were in conformance with regulations and rules therefore as required in the current manual of survey instructions of the United States Department of the interior, Bureau of Land Management or by a decree of a Court of Law and/or that the corner points mentioned in lines 3, 4 and 5 above were in conformance with the rules of the Michigan Board of Land Surveyors or by a Decree of a Court of Law; established, re-established, monumented, re-monumented, recovered, found as expressed below:

NOTE: Not more than 4 corners, all in the same town and range, may be recorded on this certificate.

A. Description of original monument and accessories and/or subsequent restoration:

M-4	1837	G.L.O. Notes	Cathcart	Set Post
	1963	Records	MDOT	Stone and Wood Stake
	1987	L.C.R.C. #4534	John Bueche	Fnd. Stone & Axle Shaft / Set K.C. Monument
	1994	L.C.R.C. #7257	Glaza & Associates	K.C. Monument

P.A. 345 1990 KENT COUNTY  
PEER APPROVED 10/25/99  
CHAIRMAN [Signature]

Note: This corner is common with A-4, T9N, R8W.

This corner was originally approved by the Kent County Remonumentation Peer Group and monumented by John Bueche on 3/11/86 and was recorded per L.C.R.C. #4534.

B. Description of corner evidence found and/or method applied in restoring or reestablishing corner:

M-4 Found a Standard Kent County Monument at the C/L intersection of Montcalm Avenue (gravel) running North and South and Station Street (gravel) running East per L.C.R.C.'s #4534 and #7257 as set by John Bueche in place of a stone and axle shaft he found which checked with the 1963 MDOT records.

L.C.R.C. #4534

Capped iron 1' S. of MI Bell Telephone Box N 40° W 48.88'

L.C.R.C. #7257


Capped iron 1' S of Mich Bell telephone box N40°W 48.92' (m. 48.91')

The selected location is accepted by me and is generally accepted by professional surveyors as the best available evidence of the position of the original corner.

C. Description of monument for corner and accessories established to perpetuate locating the position of the corner:

M-4 Standard Kent County Monument

- Nail & K.C. remon. tag on NW side 5" post N 45° E 84.12'
- Nail & K.C. remon. tag on SW side 5" post S 55° E 72.08'
- Nail & K.C. remon. tag on SE side 5" post S 35° W 103.49'
- Nail & K.C. remon. tag on S'y side 5" post S 70° W 58.56'
- Nail & K.C. remon. tag on E side 5" post N 20° W 135.90'
- Capped rod N 40° W 48.91'
- Axle shaft S 02° E 6.12'
- C/L "X" of gravel roads running N-S & E

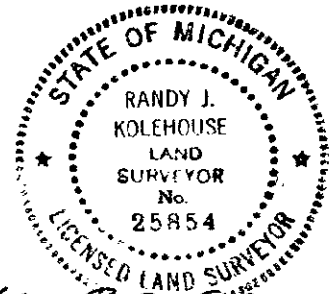

Signed by Randy J. Kolehouse Date 10-29-99

WILLIAMS & WORKS

Surveyor's Michigan License No. 25854