

MAY 22 2000

\$7.00  
\$2.00

LAND CORNER RECORDATION CERTIFICATE  
Filing Requirement of Act 74, Mich. P.A. 1970  
KENT COUNTY REMONUMENTATION

SECTION

For corners in

| Kent<br>(County)                      | Located in: Oakfield<br>Township | Corner Code # |
|---------------------------------------|----------------------------------|---------------|
| 1. Public Land Survey                 | T 9N R 9W                        | M-6           |
|                                       | T _____ R _____                  | _____         |
|                                       | T _____ R _____                  | _____         |
|                                       | T _____ R _____                  | _____         |
| 2. Property Controlling<br>in Section | S _____ T _____ R _____          | _____         |
|                                       | S _____ T _____ R _____          | _____         |
| 3. Miscellaneous<br>Property in Sec.  | S _____ T _____ R _____          | _____         |
|                                       | S _____ T _____ R _____          | _____         |

REG. OF DEEDS

STATE OF MICHIGAN  
COUNTY OF KENT  
RECEIVED FOR RECORD  
1999 DEC 27 AM 8:20

11669

Register of Deeds Stamp & File Number

- 4. Lot No. \_\_\_\_\_, Recorded Plat \_\_\_\_\_
- 5. Private Claims \_\_\_\_\_

I, Randy Kolehouse, in a field survey on September 20 19 99, do hereby certify that under requirements of P.A. 74 Michigan P.A. of 1970, the corner points mentioned in lines 1 and 2 above were in conformance with regulations and rules therefore as required in the current manual of survey instructions of the United States Department of the interior, Bureau of Land Management or by a decree of a Court of Law and/or that the corner points mentioned in lines 3, 4 and 5 above were in conformance with the rules of the Michigan Board of Land Surveyors or by a Decree of a Court of Law; established, re-established, monumented, re-monumented, recovered, found as expressed below:

NOTE: Not more than 4 corners, all in the same town and range, may be recorded on this certificate.

A. Description of original monument and accessories and/or subsequent restoration:

| M-6 | 1837    | G.L.O. Notes   | Cathcart           | Set Post                                |
|-----|---------|----------------|--------------------|---|
|     | 1958-63 | Notes          | Williams & Works   | Set Iron                                |
|     | 1963    | Records        | MDSH&T             | 3/4" Iron                               |
|     | N/A     | Witness Map    | K.C. Surveyor      | Iron                                    |
|     | 1984    | L.C.R.C. #3944 | William Byl        | Fnd. 3/4" Iron Pipe - Set K.C. Monument |
|     | 1994    | L.C.R.C. #7259 | Glaza & Associates | K.C. Monument                           |

P.A. 345 1990 KENT COUNTY  
PEER APPROVED 7/29/99  
CHAIRMAN James Hube

|    | A  | B  | C  | D  | E  | F  | G | H | I | J | K | L |
|----|----|----|----|----|----|----|---|---|---|---|---|---|
| 2  | 6  | 5  | 4  | 3  | 2  |    |   |   |   |   |   |   |
| 3  |    |    |    |    |    |    |   |   |   |   |   |   |
| 4  | 7  | 8  | 9  | 10 | 11 | 12 |   |   |   |   |   |   |
| 5  |    |    |    |    |    |    |   |   |   |   |   |   |
| 6  | 18 | 17 | 16 | 15 | 14 | 13 |   |   |   |   |   |   |
| 7  |    |    |    |    |    |    |   |   |   |   |   |   |
| 8  | 19 | 20 | 21 | 22 | 23 | 24 |   |   |   |   |   |   |
| 9  |    |    |    |    |    |    |   |   |   |   |   |   |
| 10 | 30 | 29 | 28 | 27 | 26 | 25 |   |   |   |   |   |   |
| 11 |    |    |    |    |    |    |   |   |   |   |   |   |
| 12 | 31 | 32 | 33 | 34 | 35 | 36 |   |   |   |   |   |   |
| 13 |    |    |    |    |    |    |   |   |   |   |   |   |

Note: This corner is common with A-6, T9N, R8W.

This corner was originally approved by the Kent County Remonumentation Peer Group and monumented by William Byl on 8/30/84 and was recorded per L.C.R.C. #3944.

B. Description of corner evidence found and/or method applied in restoring or reestablishing corner:

M-6 Found a Standard Kent County Monument on the C/L of Montcalm Avenue (gravel) running North and South per L.C.R.C.'s #3944 and #7259 as set by William Byl in place of a 3/4" iron pipe which checked with the 1963 records of MDSH&T and the 1958-63 notes of Williams & Works.

L.C.R.C. #3944

L.C.R.C. #7259

Nail & tag, E. sd. Power pole S 40 W 86.51'  
Nail & tag, S. sd. 10" Oak N 40 W 45.01'  
Nail & tag, N. sd. Power pole S 75 E 258.22'


Nail & K.C. remon tag in E side P. pole S38°W 86.41'  
Nail & K.C. remon tag in SW side 10" Oak N44°W 44.90'  
Nail & K.C. remon tag in N side P. pole S77°E 258.11'

The selected location is accepted by me and is generally accepted by professional surveyors as the best available evidence of the position of the original corner.

C. Description of monument for corner and accessories established to perpetuate locating the position of the corner:

M-6 Standard Kent County Monument

Nail & K.C. remon. tag on E side P. pole S 38° W 86.41'  
Nail & K.C. remon. tag on SW side 11" Oak N 44° W 44.90'  
Nail & K.C. remon. tag on N side P. pole S 77° E 258.11'  
Nail & K.C. remon. tag on S side 8" Cherry N 75° E 95.59'  
Nail & K.C. remon. tag on S side 8" Walnut N 88° E 191.66'  
On C/L of gravel road running N-S

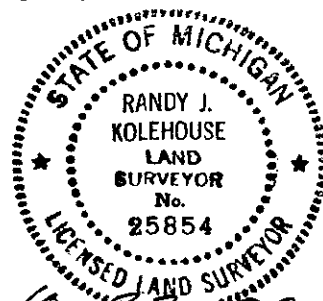

Signed by Randy J. Kolehouse Date 10-22-99

WILLIAMS & WORKS

Surveyor's Michigan License No. 25854