

\$7.00  
\$2.00

MAY 28 2000

SECTION

LAND CORNER RECORDATION CERTIFICATE  
Filing Requirement of Act 74, Mich. P.A. 1970  
KENT COUNTY REMONUMENTATION

For corners in

Kent (County)	Located in: Oakfield Township	Corner Code #
1. Public Land Survey	T <u>9N</u> R <u>9W</u>	<u>M-9</u>
	T _____ R _____	_____
	T _____ R _____	_____
	T _____ R _____	_____
2. Property Controlling in Section	S _____ T _____ R _____	_____
	S _____ T _____ R _____	_____
3. Miscellaneous Property in Sec.	S _____ T _____ R _____	_____
	S _____ T _____ R _____	_____

REG. OF DEEDS

*[Signature]*

STATE OF MICHIGAN  
COUNTY OF KENT  
RECEIVED FOR RECORD  
1999 DEC - 8 AM 10: 10

11580

Register of Deeds Stamp & File Number

4. Lot No. \_\_\_\_\_, Recorded Plat \_\_\_\_\_  
5. Private Claims \_\_\_\_\_

I, Randy Kolehouse, in a field survey on October 5 19 99, do hereby certify that under requirements of P.A. 74 Michigan P.A. of 1970, the corner points mentioned in lines 1 and 2 above were in conformance with regulations and rules therefore as required in the current manual of survey instructions of the United States Department of the interior, Bureau of Land Management or by a decree of a Court of Law and/or that the corner points mentioned in lines 3, 4 and 5 above were in conformance with the rules of the Michigan Board of Land Surveyors or by a Decree of a Court of Law; established, re-established, monumented, re-monumented, recovered, found as expressed below:

NOTE: Not more than 4 corners, all in the same town and range, may be recorded on this certificate.

	A	B	C	D	E	F	G	H	I	J	K	L	M
13													

A. Description of original monument and accessories and/or subsequent restoration:

M-9	1837	G.L.O.' Notes	Cathcart	Set Post	P.A. 345 1990 KENT COUNTY
	1939	Witness Map	K.C. Surveyor	Conc. Monument	PEER APPROVED <u>10/28/99</u>
	N/A	Survey L. 86 P. 6	N/A	Set Iron Pipe	CHAIRMAN <u>[Signature]</u>
	1983	L.C.R.C. #3336	Glaza & Associates	Iron Pipe	
	1983	L.C.R.C. #3590	William Byl	Iron Pipe & Fence Post	
	1984	L.C.R.C. #3735	Williams & Works	Fnd. Iron Pipe / Set K.C. Monument	
	1994	L.C.R.C. #7262	Glaza & Associates	K.C. Monument	

Note: This corner is common with A-9, T9N, R8W.

This corner was originally approved by the Kent County Remonumentation Peer Group and monumented by Williams & Works on 2/1/84 and was recorded per L.C.R.C. #3735.

B. Description of corner evidence found and/or method applied in restoring or reestablishing corner:

M-9 Found a Standard Kent County Monument in a swamp with no occupation in area per L.C.R.C.'s #3735 and #7262 as set by Williams & Works in place of an iron pipe with cap they found which checked Survey L. 86 P. 6 and L.C.R.C.'s #3590 and #3336.

L.C.R.C. #3735

L.C.R.C. #7262

Nail & KC Remon. tag in E. face 12" Maple N.14°E. 29.81'  
Nail & KC Remon. tag in N. face 12" Maple N.80°E. 30.33'  
Nail & KC Remon. tag in S. face 12" Cedar (in group of 5)  
S.75°E. 8.51'

Nail & K.C. remon tag in E side 12" Maple N14°E 29.77' (m. 29.78')  
Nail & K.C. remon tag in N side 12" Maple N60°E 30.30'  
Nail & K.C. remon tag in S side 14" Cedar (in group of 5)  
S75°E 8.68' (m. 8.67')

Nail & KC Remon. tag in S. face 14" Maple S.64°E. 34.38'  
Nail & KC Remon. tag in S. face 8" Ash S.50°W. 3.80'  
Nail & KC Remon. tag in NE face 10" Yellow Birch N.68°W. 14.52'


Nail & K.C. remon tag in S side 18" Maple S64°E 34.38' (m. 34.36')  
Nail & K.C. remon tag in S side 10" Ash S50°W 3.87' (m. 3.91')  
Nail & K.C. remon tag in NE side 10" Tw.Yellow Birch N68°W 14.48' (m. 14.52')

The selected location is accepted by me and is generally accepted by professional surveyors as the best available evidence of the position of the original corner.

C. Description of monument for corner and accessories established to perpetuate locating the position of the corner:

M-9 Standard Kent County Monument

Nail & K.C. remon. tag on E side 12" Maple N 14° E 29.78'  
Nail & K.C. remon. tag on N side 12" Maple N 60° E 30.30'  
Nail & K.C. remon. tag on S side 14" Cedar (in group of 5) S 75° E 8.67'  
Nail & K.C. remon. tag on S side 18" Maple S 64° E 34.36'  
Nail & K.C. remon. tag on S side 10" Ash S 50° W 3.91'  
Nail & K.C. remon. tag on NE side 10" twin Yellow Birch N 68° W 14.52'

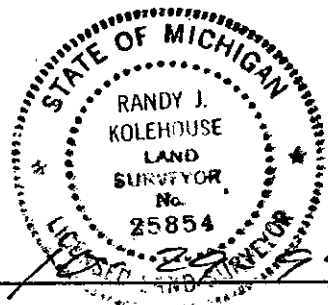

Signed by Randy J. Kolehouse Date \_\_\_\_\_

Surveyor's Michigan License No. 25854