

MAY 28 2000

\$7.00
\$2.00

SECTION

LAND CORNER RECORDATION CERTIFICATE
Filing Requirement of Act 74, Mich. P.A. 1970
KENT COUNTY REMONUMENTATION

For corners in

Kent (County)	Located in: Oakfield Township	Corner Code #
1. Public Land Survey	T 9N R 9W	M-11
	T R	
	T R	
	T R	
2. Property Controlling in Section	S T R	
	S T R	
3. Miscellaneous Property in Sec.	S T R	
	S T R	

STATE OF MICHIGAN
COUNTY OF KENT
RECEIVED FOR RECORD

1999 DEC 27 AM 8:20

REG. OF DEEDS

[Signature]

11673

Register of Deeds Stamp & File Number

4. Lot No. _____, Recorded Plat _____
5. Private Claims _____


I, Randy Kolehouse, in a field survey on March 26 19 99, do hereby certify that under requirements of P.A. 74 Michigan P.A. of 1970, the corner points mentioned in lines 1 and 2 above were in conformance with regulations and rules therefore as required in the current manual of survey instructions of the United States Department of the interior, Bureau of Land Management or by a decree of a Court of Law and/or that the corner points mentioned in lines 3, 4 and 5 above were in conformance with the rules of the Michigan Board of Land Surveyors or by a Decree of a Court of Law; established, re-established, monumented, re-monumented, recovered, found as expressed below:

NOTE: Not more than 4 corners, all in the same town and range, may be recorded on this certificate.

A. Description of original monument and accessories and/or subsequent restoration:

M-11	1837	G.L.O. Notes	Cathcart	Set Post
	1986	L.C.R.C. #4366	Randy Kolehouse	Set K.C. Monument
	1984	L.C.R.C. #7264	Glaza & Associates	K.C. Monument

P.A. 345 1990 KENT COUNTY
PEER APPROVED 7/29/99
CHAIRMAN [Signature]

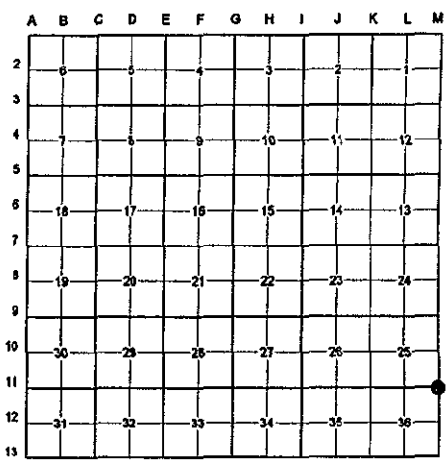

Note: This corner is common with A-11, T9N, R8W.

This corner was originally approved by the Kent County Remonumentation Peer Group and monumented by Randy Kolehouse on 11/2/85 and was recorded per L.C.R.C. #4366.

B. Description of corner evidence found and/or method applied in restoring or reestablishing corner:

M-11 Found a Standard Kent County Monument on the C/L of Montcalm Avenue (gravel) running North and South per L.C.R.C.'s #4366 and #7264 as set by Randy Kolehouse.

L.C.R.C. #4366

L.C.R.C. #7264

Nail & K.C. Remon. tag in W. side P.Pole S 35° E 119.3'
Nail & K.C. Remon. tag in E. side P.Pole N 35° W 105.18'
In C/L Montcalm Ave. (gravel) running North & South.


Nail & K.C. remon tag in W side P. pole S35°E 119.30' (m. 119.34')
Nail & K.C. remon tag in E side P. pole N28°W 105.10' (m. 105.14')
In C/L Montcalm Ave. (gravel) running North & South
Nail & K.C. remon tag in E side P. pole S03°W 450.64' (m. 450.61')
C/L 2" Peach Tree S87°E 24.30'

The selected location is accepted by me and is generally accepted by professional surveyors as the best available evidence of the position of the original corner.

C. Description of monument for corner and accessories established to perpetuate locating the position of the corner:

M-11 Standard Kent County Monument

Nail & K.C. remon. tag on W side P. pole S 35° E 119.34'
Nail & K.C. remon. tag on E side P. pole N 28° W 105.14'
Nail & K.C. remon. tag on E side P. pole S 03° W 450.61'
C/L 3" Apple S 87° E 24.30'
Nail & K.C. remon. tag on E side 20" Oak N 03° W 323.86'
On C/L of gravel road running N-S

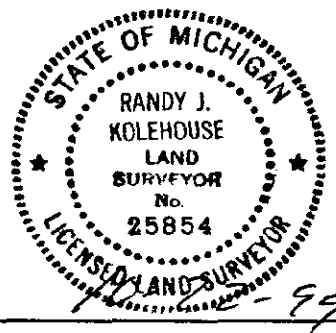

Signed by [Signature] Date _____

WILLIAMS & WORKS

Surveyor's Michigan License No. 25854