

\$7.00  
\$2.00

MAY 22 2000

LAND CORNER RECORDATION CERTIFICATE  
Filing Requirement of Act 74, Mich. P.A. 1970  
KENT COUNTY REMONUMENTATION

REG. OF DEEDS

STATE OF MICHIGAN  
COUNTY OF KENT  
RECEIVED FOR RECORD  
1999 DEC 27 AM 8:20

For corners in SECTION  
Kent (County)

Located in: Oakfield Township Corner Code #

1. Public Land Survey	T 9N	R 9W	M-12
	T	R	
	T	R	
	T	R	
2. Property Controlling in Section	S	T	R
	S	T	R
3. Miscellaneous Property in Sec.	S	T	R
	S	T	R

11674

Register of Deeds Stamp & File Number

- 4. Lot No. \_\_\_\_\_, Recorded Plat \_\_\_\_\_
- 5. Private Claims \_\_\_\_\_

I, Randy Kolehouse, in a field survey on March 26 19 99, do hereby certify that under requirements of P.A. 74 Michigan P.A. of 1970, the corner points mentioned in lines 1 and 2 above were in conformance with regulations and rules therefore as required in the current manual of survey instructions of the United States Department of the Interior, Bureau of Land Management or by a decree of a Court of Law and/or that the corner points mentioned in lines 3, 4 and 5 above were in conformance with the rules of the Michigan Board of Land Surveyors or by a Decree of a Court of Law; established, re-established, monumented, re-monumented, recovered, found as expressed below:

**NOTE: Not more than 4 corners, all in the same town and range, may be recorded on this certificate.**

A. Description of original monument and accessories and/or subsequent restoration:

M-12 1837	G.L.O. Notes	Cathcart	Set Post
1986	L.C.R.C. #4367	Randy Kolehouse	Set K.C. Monument
1994	L.C.R.C. #7265	Glaza & Associates	K.C. Monument

Note: This corner is common with A-12, T9N, R8W.

This corner was originally approved by the Kent County Remonumentation Peer Group and monumented by Randy Kolehouse on 11/2/85 and was recorded per L.C.R.C. #4367.

B. Description of corner evidence found and/or method applied in restoring or reestablishing corner:

M-12 Found a Standard Kent County Monument on the C/L of Montcalm Avenue (gravel) extended South and running North, on line of a tree row running East, per L.C.R.C.'s #4367 and #7265 as set by Randy Kolehouse.

L.C.R.C. #4367

- Nail & K.C. Remon. tag in N. side 40" Oak S 70° W 31.50'
- Nail & K.C. Remon. tag in S. side 40" Oak S 60° E 38.45'
- Nail & K.C. Remon. tag in W. side 3" W. Cherry S 15° E 29.96'
- South end of Montcalm Ave. as improved North 10' m/l

L.C.R.C. #7265


- Nail & K.C. remon tag in SW side 40" Oak S60°E 38.53' (m. 38.55')
- Nail & K.C. remon tag in W side 6" W. Cherry S15° E 29.90' (m. 29.92')
- South end of Montcalm Ave. as improved North 10' m/l
- Nail & K.C. remon tag in W side wood post N42°W 56.86' (m. 56.87')
- Nail & K.C. remon tag in N side 40" stump S74°W 32.36' (m. 32.33')

The selected location is accepted by me and is generally accepted by professional surveyors as the best available evidence of the position of the original corner.

C. Description of monument for corner and accessories established to perpetuate locating the position of the corner:

M-12 Standard Kent County Monument

- Nail & K.C. remon. tag on N side 40" Oak S 60° E 38.55'
- Nail & K.C. remon. tag on W side wood post N 42° W 56.87'
- Nail & K.C. remon. tag on N side 40" stump S 74° W 32.33'
- Nail & K.C. remon. tag on W side 8" W. Cherry S 15° E 29.92'
- Nail & K.C. remon. tag on N side 2" Pine S 85° E 84.39'
- On tree row running E
- On C/L of gravel road running North extended South

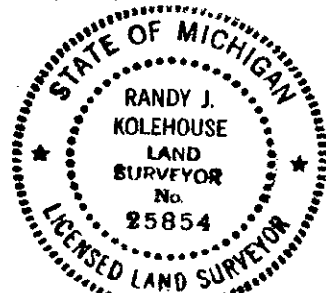

Signed by Randy J. Kolehouse Date 10-22-99

WILLIAMS & WORKS

Surveyor's Michigan License No. 25854