

SURVEY & REMONUMENTATION

\$7.00
\$2.00

MAR 08 1999

LAND CORNER RECORDATION CERTIFICATE
Filing Requirement of Act 74, Mich. P.A. 1970
KENT COUNTY REMONUMENTATION

For corners in SECTION

Kent (County)	Located in: Oakfield Township	Corner Code #
1. Public Land Survey	T <u>9N</u> R <u>9W</u>	<u>M-13</u>
	T _____ R _____	_____
	T _____ R _____	_____
	T _____ R _____	_____
2. Property Controlling in Section	S _____ T _____ R _____	_____
	S _____ T _____ R _____	_____
3. Miscellaneous Property in Sec.	S _____ T _____ R _____	_____
	S _____ T _____ R _____	_____

STATE OF MICHIGAN
COUNTY OF KENT
RECEIVED FOR RECORD
38 DEC 14 AM 8:00
REG. OF DEEDS
Luci Bond

10961

Register of Deeds Stamp & File Number

4. Lot No. _____, Recorded Plat _____
5. Private Claims _____

I, Randy Kolehouse, in a field survey on January 28 19 98, do hereby certify that under requirements of P.A. 74 Michigan P.A. of 1970, the corner points mentioned in lines 1 and 2 above were in conformance with regulations and rules therefore as required in the current manual of survey instructions of the United States Department of the interior, Bureau of Land Management or by a decree of a Court of Law and/or that the corner points mentioned in lines 3, 4 and 5 above were in conformance with the rules of the Michigan Board of Land Surveyors or by a Decree of a Court of Law; established, re-established, monumented, re-monumented, recovered, found as expressed below:

NOTE: Not more than 4 corners, all in the same town and range, may be recorded on this certificate.

A. Description of original monument and accessories and/or subsequent restoration:

M-13	1837	G.L.O. Notes	N. Brookfield	Set Post
	1979	L.C.R.C. #1281	J. Fletcher	Set 1/2" Iron Rod
	1981	L.C.R.C. #1677	Williams & Works	Fnd. 1/2" Iron Rod / Set K.C. Monument
	1994	L.C.R.C. #7266	Glaza & Associates	K.C. Monument

	A	B	C	D	E	F	G	H	I	J	K	L	M
2	6		5		4		3		2		1		
3													
4	7		8		9		10		11		12		
5													
6	13		17		16		15		14		13		
7													
8	19		20		21		22		23		24		
9													
10	30		29		28		27		26		25		
11													
12	31		32		33		34		35		36		
13													

Note: This corner is common with M-1, T8N, R9W; A-13, T9N, R8W; A-1, T8N, R8W

This corner was originally approved by the Kent County Remonumentation Peer Group and monumented by Williams & Works on 2/26/81 and was recorded per L.C.R.C. #1677.

P.A. 345 1990 KENT COUNTY
PEER APPROVED 9/24/98
CHAIRMAN Randy Kolehouse

B. Description of corner evidence found and/or method applied in restoring or reestablishing corner:

M-13 Found a Standard Kent County Monument at the C/L intersection of Montcalm Avenue (gravel) running South, 10 Mile Road (gravel) running West, and Bricker Road (bit.) running East per L.C.R.C.'s #1677 and #7266 as set by Williams & Works in place of a 1/2" iron rod they found which checked L.C.R.C. #1281.

L.C.R.C. #1677

L.C.R.C. #7266

Nail & K.C. Remon. Tag in S'ly Side 22" Oak N 75°W 90.28'
Nail & K.C. Remon. Tag in NE Side 24" Hickory N 25°W 61.40'
Nail & K.C. Remon. Tag in W Side 10" Twin Oak N 12°E 38.90'
Nail & K.C. Remon. Tag in N Side 8" Apple S 58°E 92.61'


Nail & K.C. remon tag in S'ly side 24" Oak N75°W 90.23'
Nail & K.C. remon tag in NE side 24" Hickory N25°W 61.42' (m. 61.44')
Nail & K.C. remon tag in W side 18" Twin Oak N12°E 38.79' (m. 38.81')
Nail & K.C. remon tag in N side 8" Apple S58°E 92.61' (m. 92.65')

The selected location is accepted by me and is generally accepted by professional surveyors as the best available evidence of the position of the original corner.

C. Description of monument for corner and accessories established to perpetuate locating the position of the corner:

M-13 Standard Kent County Monument

Nail & K.C. remon. tag on S'ly side 24" Oak N 75° W 90.23'
Nail & K.C. remon. tag on NE side 24" Oak N 25° W 61.44'
Nail & K.C. remon. tag on W side 18" twin Oak N 12° E 38.81'
Nail & K.C. remon. tag on N side 8" Apple S 58° E 92.65'
On C/L of gravel road running S
On C/L of gravel road running W
On C/L of bit. road running E

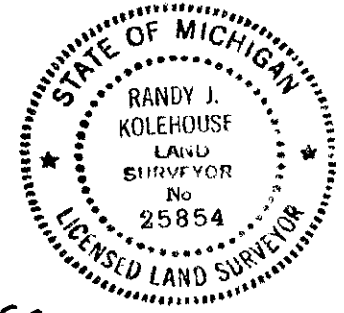

Signed by Randy J. Kolehouse
EARTH TECH

Date 11/18/98

Surveyor's Michigan License No. 25854