

KENT COUNTY REMONUMENTATION
LAND CORNER RECORDATION CERTIFICATE

Filing Requirement of Act 74, Mich. P.A. 1970

For corners in

Oakfield Township

Kent	Located In:	Corner Code #
(County)		
1. Public Land Survey	T _____ R _____	<i>Other Code</i>
	T _____ R _____	<i>#11</i>
	T _____ R _____	
	T _____ R _____	
2. Property Controlling in Section	S 28 T 9N R 9W	Witness Mon. on
	S _____ T _____ R _____	the South end
3. Miscellaneous Property in Sec.	S _____ T _____ R _____	of West line
	S _____ T _____ R _____	Section 28
4. Lot No. _____	Recorded Plat _____	
5. Private Claims _____		

Chris Marshall
 Surveyor

6831A

Register of Deeds Stamp & File Number

	A	B	C	D	E	F	G	H	I	J	K	L	M
2	6	5	4	3	2	1							
3													
4	7	8	9	10	11	12							
5													
6	18	17	16	15	14	13							
7													
8	19	20	21	22	23	24							
9													
10	30	29	28	27	26	25							
11													
12	31	32	33	34	35	36							
13													

Chris Marshall, in a field survey on June 11, 1993
 do hereby certify that under requirements of P.A. 74, Michigan P.A. of 1970, the corner points mentioned in lines 1 and 2 above were in conformance with regulations and rules therefore as required in the current manual of survey instructions of the United States Department of the Interior, Bureau of Land Management or by a decree of a Court of Law and/or that the corner points mentioned in lines 3, 4 and 5 above were in conformance with the rules of the Michigan Board of Land Surveyors or by a Decree of a Court of Law; established, re-established, monumented, re-monumented, recovered, found as expressed below:

NOTE: Not more than 4 corners, all in the same town and range, may be recorded on this certificate.


A. Description of original monument and accessories and/or subsequent restoration:
 None

B. Description of corner evidence found and/or method applied in restoring or reestablishing corner:
 Established the line between Sections 28 and 29 as straight for the mile. This line hits an Iron pipe in the E & W fence approximately 1300' South of the NW corner of Section 28.

C. Description of monument for corner and accessories established to perpetuate locating the position of the corner:
 Set Standard Harrison Monument with witness cap on the West line of Section 28, 650' South of the NW corner Section 28.
 Centerline gravel drive to the E. South 40' more or less
 Centerline Wabasis Road at right angles to the curve 23' more or less
 Nail & Tag E. sd 12" Elm S18° E 7.94'
 Nail & Tag S. sd 14" Ash S54° E 30.57'
 NW corner of the East conc. headwall (3'x.5') (for Old Wabasis Rd., Now abandoned) S51° E 27.39'
 Top centerline of E. end 15" conc. pipe S02° W 23.33'

Signed by Chris Marshall Date July 7, 1993
 Surveyor's Michigan License No. 18661

See other side

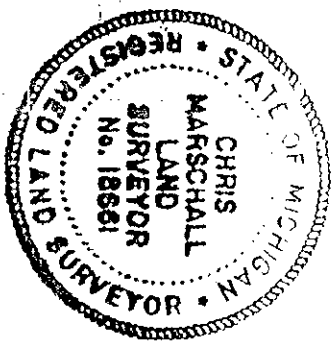

29

28

Bearings established
Lake by solar observations

SECTION 28 AND 29, T9N, R9W,
OAKFIELD TOWNSHIP, KENT COUNTY
MICHIGAN

I, Chris Marschall a Professional Surveyor in the State of Michigan, HEREBY CERTIFY that I have surveyed the parcel(s) of land described and delineated hereon; that said plot is a true representation of the survey as performed by me, and that there are no encroachments other than as shown hereon; that said survey was performed with an error of closure 1/50,000 and that I have fully complied with the requirements of Act # 132, P.A. 1970.

By Chris Marschall date 6-19-93

CHRIS MARSCHALL P.S. No. 18661

- LEGEND
- ◆ - Witness Monument (Harrison Monument - SET)
 - - Government Corner (Harrison Monument - EXISTING)
 - - Center of Section (Harrison Monument - SET)
 - △ - Concrete Monument (Plot Corner - EXISTING)
 - - Pent along Line (1/2" iron - SET)

LMN
ENGINEERING
CONSULTANTS
INC.

4095 CHICAGO DRIVE
GRANDVILLE, MI. 48418
(616)-531-0710

68318

Register of Deeds, County of _____
This survey was received for record on the _____ day
of _____, 19__ at _____ M. recorded in Liber _____
of Surveyors Page _____

