

**SURVEY &
REMONUMENTATION**

MAY 22 2000

\$7.00
\$2.00

SECTION

**LAND CORNER RECORDATION CERTIFICATE
Filing Requirement of Act 74, Mich. P.A. 1970
KENT COUNTY REMONUMENTATION**

For corners in

<u>Kent</u> (County)	Located in: <u>Oakfield</u> Township	Corner Code #
1. Public Land Survey	T <u>9N</u> R <u>9W</u>	Witness Mon. _____
	T _____ R _____	_____
	T _____ R _____	_____
	T _____ R _____	_____
2. Property Controlling in Section	S _____ T _____ R _____	East of G-11 _____
	S _____ T _____ R _____	_____
3. Miscellaneous Property in Sec.	S _____ T _____ R _____	_____
	S _____ T _____ R _____	_____

STATE OF MICHIGAN
COUNTY OF KENT
RECEIVED FOR RECORD

1999 DEC - 8 AM 10:06

REG. OF DEEDS

Handwritten: "other" #7
Seq #2
11557

Register of Deeds Stamp & File Number

4. Lot No. _____, Recorded Plat _____
5. Private Claims _____

	A	B	C	D	E	F	G	H	I	J	K	L	M
2													
3													
I, Randy Kolehouse in a field survey on March 24 19 99, do hereby certify that under requirements of P.A. 74 Michigan P.A. of 1970, the corner points mentioned in lines 1 and 2 above were in conformance with regulations and rules therefore as required in the current manual of survey instructions of the United States Department of the interior, Bureau of Land Management or by a decree of a Court of Law and/or that the corner points mentioned in lines 3, 4 and 5 above were in conformance with the rules of the Michigan Board of Land Surveyors or by a Decree of a Court of Law; established, re-established, monumented, re-monumented, recovered, found as expressed below:

NOTE: Not more than 4 corners, all in the same town and range, may be recorded on this certificate.

A. Description of original monument and accessories and/or subsequent restoration:

G-11	1837	G.L.O. Notes	Cathcart	Set Post
	N/A	Survey L. 218 P. 31	Roosien	Iron
	1949	Lewis Wabasis Park Plat L. 45 P. 34	N/A	Plat Monument
	1993	L.C.R.C. #6826	Chris Marschall	Set Kent County Witness Monument
	1997	L.C.R.C. #9688	Kirk Breitels	Kent County Witness Monument

P.A. 345 1990 KENT COUNTY
PEER APPROVED 7/29/99
CHAIRMAN [Signature]

This corner was originally approved by the Kent County Remonumentation Peer Group in May of 1993 and was recorded per L.C.R.C. #6826.

B. Description of corner evidence found and/or method applied in restoring or reestablishing corner:
G-11 Found a Kent County Witness Monument 28' + West of bituminous drive to trailer park per L.C.R.C.'s #6826 and #9688 as set by Chris Marschall in place of a Roosien iron he found and held for the Southwest corner of the Southeast 1/4 of the Southwest 1/4 of Section 7.

L.C.R.C. #6826

L.C.R.C. #9688


Nail and Tag in NW side of U.P. (5' above grade) N 21°E 196.77'
Nail and Tag in NE side of U.P. S 19°E 121.02'
Nail and Tag in NE side of 30" Poplar (5' above grade) S 34°E 134.98'
Center of 20' Bit. Drive to Trailer Park East 28'+/-
Chiseled x in NW corner of concrete dumpster pad S 11°E 159.54'

Nail & KC Remon. tag NW side Util. Pole N21°E 196.77' (m. 196.68')
Nail & KC Remon. tag NE side Util. Pole S19°E 121.02' (m. 121.09')
Nail & KC Remon. tag NE side 32" Oak S34°E 134.98' (m. 134.96')
Center of 20' Bit. Drive to Trailer Park East 28'+/-
Chiseled "X" in NW corner of conc. dumpster pad S11°E 159.54'

The selected location is accepted by me and is generally accepted by professional surveyors as the best available evidence of the position of the original corner.

C. Description of monument for corner and accessories established to perpetuate locating the position of the corner:

G-11 Standard Kent County Witness Monument
Nail & K.C. remon. tag on NW side Util. pole N 21° E 196.68'
Nail & K.C. remon. tag on NW side Util. pole S 19° E 121.02'
Nail & K.C. remon. tag on NE side 32" Oak S 34° E 134.96'
"X" cut NW cor. conc. dumpster pad S 11° E 159.54'
Nail & K.C. remon. tag on W side 12" Aspen N 03° E 17.97'

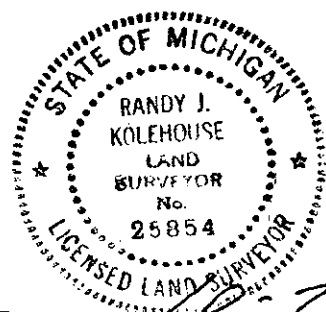

See Drawing - L.C.R.C. #6826B
Signed by [Signature] Date 7-29-99
WILLIAMS & WORKS

Surveyor's Michigan License No. 25854