

**SURVEY &  
REMONUMENTATION**

MAY 22 2000

**LAND CORNER RECORDATION CERTIFICATE  
Filing Requirement of Act 74, Mich. P.A. 1970  
KENT COUNTY REMONUMENTATION**

*other # 8*  
*Seq # 2*

1999 DEC 30 AM 9:21  
STATE OF MICHIGAN  
COUNTY OF KENT  
RECEIVED FOR RECORD

REG. OF DEEDS  
*[Signature]*  
**11688**  
Register of Deeds Stamp & File Number

For corners in

**SECTION**

<u>Kent</u> (County)	Located in: <u>Oakfield</u> Township	Corner Code #
1. Public Land Survey	T <u>9N</u> R <u>9W</u>	<u>E-10</u>
	T _____ R _____	<u>West Witness</u>
	T _____ R _____	<u>Monument</u>
	T _____ R _____	_____
2. Property Controlling in Section	S _____ T _____ R _____	_____
	S _____ T _____ R _____	_____
3. Miscellaneous Property in Sec.	S _____ T _____ R _____	_____
	S _____ T _____ R _____	_____

4. Lot No. \_\_\_\_\_, Recorded Plat \_\_\_\_\_  
5. Private Claims \_\_\_\_\_

I, Randy Kolehouse, in a field survey on March 22 19 99, do hereby certify that under requirements of P.A. 74 Michigan P.A. of 1970, the corner points mentioned in lines 1 and 2 above were in conformance with regulations and rules therefore as required in the current manual of survey instructions of the United States Department of the Interior, Bureau of Land Management or by a decree of a Court of Law and/or that the corner points mentioned in lines 3, 4 and 5 above were in conformance with the rules of the Michigan Board of Land Surveyors or by a Decree of a Court of Law; established, re-established, monumented, re-monumented, recovered, found as expressed below:

**NOTE: Not more than 4 corners, all in the same town and range, may be recorded on this certificate.**

**A. Description of original monument and accessories and/or subsequent restoration:**

E-10 1993	L.C.R.C. #6827A	C. Marschall	Set K.C. Witness Monument
1997	L.C.R.C. #9666	Kirk Breitels	K.C. Witness Monument

P.A. 345 1990 KENT COUNTY  
PEER APPROVED 10/28/99  
CHAIRMAN [Signature]

This corner was originally approved by the Kent County Remonumentation Peer Group and monumented by C. Marschall in May 1993 and was recorded per L.C.R.C. #6827A.

**B. Description of corner evidence found and/or method applied in restoring or reestablishing corner:**

E-10 Found a Standard Kent County Witness Monument on the C/L of Tower Road (gravel) extended East and 230' East of the C/L of Wabasis Road (bit.) running Northeast-Southwest per L.C.R.C.'s #6827A and #9666 as set by Chris Marschall West of E-10 and 1,800.81' West of D-10.

L.C.R.C. #6827A

L.C.R.C. #9666

1" pipe N 89°56'28"E 20.00'  
Nail and Tag in E. side of 10" Beech N 37°E 43.80'  
Nail and Tag in E. side of 26" Oak N 09°W 51.40'  
Nail and Tag in E. side of 22" Oak S 42°W 78.16'  
Nail and Tag in S. side of 18" Oak N 78°W 93.95'


1" Pipe N89°56'28"E 20.00' (m. 20.05')  
Nail & KC Remon. tag E. side 10" Beech N37°E 43.80'  
Nail & KC Remon. tag E. side 28" Oak N09°W 51.43' (m. 51.42')  
Nail & KC Remon. tag E. side 24" Oak S42°W 78.19' (m. 78.20')  
Nail & KC Remon. tag S. side 18" Oak N78°W 93.98' (m. 93.97')  
East face of Easterly post N. side of parking lot is West 3.4'

The selected location is accepted by me and is generally accepted by professional surveyors as the best available evidence of the position of the original corner.

**C. Description of monument for corner and accessories established to perpetuate locating the position of the corner:**

E-10 Standard Kent County Witness Monument

Nail & K.C. remon. tag on E side 10" Beech N 37° E 43.80'  
Nail & K.C. remon. tag on E side 26" Oak N 09° W 51.42'  
Nail & K.C. remon. tag on E side 22" Oak S 42° W 78.20'  
Nail & K.C. remon. tag on S side 18" Oak N 78° W 93.97'  
1" pipe N 89° E 20.05'

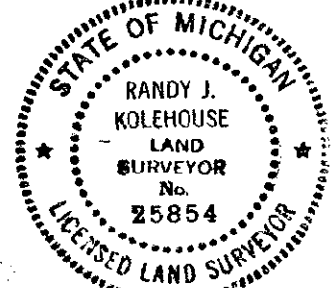

Signed by Randy J. Kolehouse  
WILLIAMS & WORKS

Date 12-28-99

Surveyor's Michigan License No. 25854

