

SURVEY & REMONUMENTATION

\$7.00
\$2.00

MAY 22 2000

LAND CORNER RECORDATION CERTIFICATE
Filing Requirement of Act 74, Mich. P.A. 1970
KENT COUNTY REMONUMENTATION

"other" # 11
seq # 2


For corners in SECTION

Kent (County)	Located in: Oakfield Township	Corner Code #
1. Public Land Survey	T <u>9N</u> R <u>9W</u>	<u>E-10</u>
	T _____ R _____	<u>North Witness</u>
	T _____ R _____	<u>Monument</u>
	T _____ R _____	_____
2. Property Controlling in Section	S _____ T _____ R _____	_____
	S _____ T _____ R _____	_____
3. Miscellaneous Property in Sec.	S _____ T _____ R _____	_____
	S _____ T _____ R _____	_____

1999 DEC 30 AM 9:24
REG. OF DEEDS
STATE OF MICHIGAN
COUNTY OF KENT
RECEIVED FOR RECORD
11687
Register of Deeds Stamp & File Number

4. Lot No. _____, Recorded Plat _____
5. Private Claims _____

I, Randy Kolehouse, in a field survey on March 22 19 99, do hereby certify that under requirements of P.A. 74 Michigan P.A. of 1970, the corner points mentioned in lines 1 and 2 above were in conformance with regulations and rules therefore as required in the current manual of survey instructions of the United States Department of the Interior, Bureau of Land Management or by a decree of a Court of Law and/or that the corner points mentioned in lines 3, 4 and 5 above were in conformance with the rules of the Michigan Board of Land Surveyors or by a Decree of a Court of Law; established, re-established, monumented, re-monumented, recovered, found as expressed below:

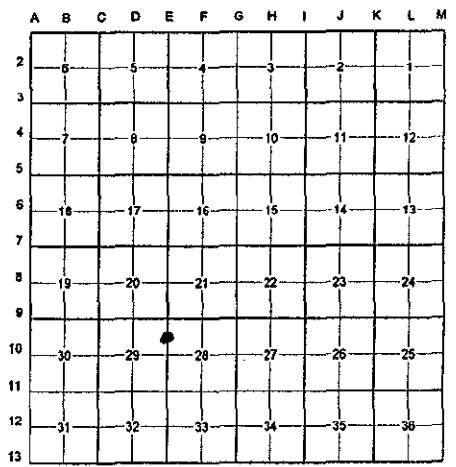

NOTE: Not more than 4 corners, all in the same town and range, may be recorded on this certificate.

- A. Description of original monument and accessories and/or subsequent restoration:
E-10 1993 L.C.R.C. #6831A C. Marschall Set K.C. Witness Monument
1997 L.C.R.C. #9664 Kirk Breitels K.C. Witness Monument

P.A. 345 1990 KENT COUNTY
PEER APPROVED 10/28/99
CHAIRMAN Randy Kolehouse

This corner was originally approved by the Kent County Remonumentation Peer Group and monumented by C. Marschall on 6/11/93 and was recorded per L.C.R.C. #6831A.

- B. Description of corner evidence found and/or method applied in restoring or reestablishing corner:
E-10 Found a Standard Kent County Witness Monument on the C/L of Wabasis Avenue (bit.) running North, extended South, per L.C.R.C.'s #6831A and #9664 as set by C. Marschall North of E-10 and 650.0' South of E-9.

<p>L.C.R.C. #6831A</p> <p>Centerline gravel drive to the E. South 40' more or less Centerline Wabasis Road at right angles to curve 23' more or less Nail & Tag E. sd 12" Elm S 18° E 7.94' Nail & Tag S. sid 14" Ash S 54° E 30.57 NW corner of East conc. Headwall (3' x 5') S 51° E 27.39' Top centerline of E. end 15" conc. pipe S 02° W 23.33'</p>	<p>L.C.R.C. #9664</p> <p>Nail & KC Remon. tag S. side 14" Ash S 54° E 30.59' (m. 30.64') NW cor. E. end conc. Headwall (3' x 5') S 51° E 27.39' (m. 27.41') Top C/L E. end 15" conc. Pipe S 02° W 23.33' (m. 23.35') C/L gravel drive to East is South 40' ± C/L Wabasis Rd. at right angles is West 23' ±</p>
--	--

The selected location is accepted by me and is generally accepted by professional surveyors as the best available evidence of the position of the original corner.

- C. Description of monument for corner and accessories established to perpetuate locating the position of the corner:
E-10 Standard Kent County Witness Monument

- Nail & K.C. remon. tag on S side 8" Ash N 50° E 25.20'
- Nail & K.C. remon. tag on N side 12" Ash S 88° E 23.86'
- Nail & K.C. remon. tag on S side 14" Ash S 54° E 30.64'
- NW cor. East end conc. headwall S 51° E 27.41'
- Top C/L East end conc 15" conc. pipe S 02° W 23.33'
- C/L of bit. road running SW & NE, West 23' ± (meas. at right angle to road)



Signed by Randy J. Kolehouse Date 12-28-99
WILLIAMS & WORKS

Surveyor's Michigan License No. 25854