

SURVEY &
REMONUMENTATION

MAY 22 2000

\$7.00
\$2.00

SECTION

LAND CORNER RECORDATION CERTIFICATE
Filing Requirement of Act 74, Mich. P.A. 1970
KENT COUNTY REMONUMENTATION

For corners in

Kent (County)	Located in: Courtland Township	Corner Code #
1. Public Land Survey	T 9N R 10W	B-3
	T R	
	T R	
	T R	
2. Property Controlling in Section	S T R	
	S T R	
3. Miscellaneous Property in Sec.	S T R	
	S T R	

REG. OF DEEDS

[Signature]

STATE OF MICHIGAN
COUNTY OF KENT
RECEIVED FOR RECORD
1999 OCT 15 AM 8:02

11268

Register of Deeds Stamp & File Number


4. Lot No. _____, Recorded Plat _____
5. Private Claims _____

I, Randy Kolehouse, in a field survey on February 18 19 99, do hereby certify that under requirements of P.A. 74 Michigan P.A. of 1970, the corner points mentioned in lines 1 and 2 above were in conformance with regulations and rules therefore as required in the current manual of survey instructions of the United States Department of the Interior, Bureau of Land Management or by a decree of a Court of Law and/or that the corner points mentioned in lines 3, 4 and 5 above were in conformance with the rules of the Michigan Board of Land Surveyors or by a Decree of a Court of Law; established, re-established, monumented, re-monumented, recovered, found as expressed below:

NOTE: Not more than 4 corners, all in the same town and range, may be recorded on this certificate.

A. Description of original monument and accessories and/or subsequent restoration:

B-3	1837	G.L.O. Notes	Cathcart	Set Post
	1900-1962	Williams & Works	K.C. Surveyor	Iron & Stone
	1984	L.C.R.C. #3894	G. Hackbardt	Monument Box
	1995	L.C.R.C. #8712	Kirk Breitels	Fnd. 1" Iron Pipe in Mon. Box / Set K.C. Monument

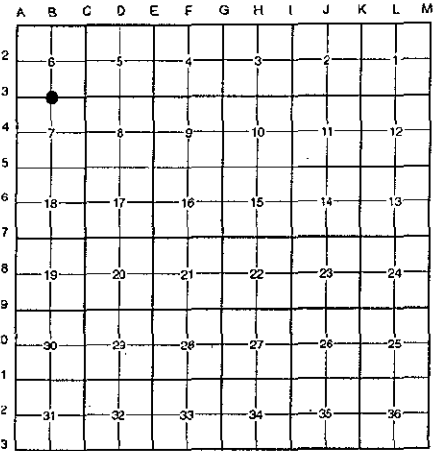

This corner was originally approved by the Kent County Remonumentation Peer Group and monumented by Kirk Breitels on 9/8/95 and was recorded per L.C.R.C. #8712.

B. Description of corner evidence found and/or method applied in restoring or reestablishing corner:

B-3 Found a Standard Kent County Monument in a monument box .5' North of the C/L of 15 Mile Road (bit.) running East and West, on line of a fence line running South, per L.C.R.C. #8712 as set by Kirk Breitels in place of a 1" x 10" iron pipe he found in a monument box over a boat spike inside a 1-1/2" iron pipe in a ring of stones which checked L.C.R.C. #3894 and the 1900-1962 notes of Williams & Works.

L.C.R.C. #8712


- Nail & KC Remon. tag W. side wood fence post S00°E 30.53' (m. 30.59')
- Nail & KC Remon. tag N. side wood fence post S70°E 90.28' (m. 90.23')
- Nail & KC Remon. tag E. side P. Pole N40°E 120.36' (m. 120.28')
- SW cor. hse. fnd. (#5197) N20°E 107.05' (m. 107.07')
- NE cor. siding hse. S60°W 160.60'

P.A. 345 1990 KENT COUNTY
PEER APPROVED 2/25/99
CHAIRMAN [Signature]

The selected location is accepted by me and is generally accepted by professional surveyors as the best available evidence of the position of the original corner.

C. Description of monument for corner and accessories established to perpetuate locating the position of the corner:

- B-3 Standard Kent County Monument in a Monument Box
- Nail & K.C. remon. tag on W side wood fence post S 00° E 30.59'
 - Nail & K.C. remon. tag on N side wood fence post S 70° E 90.23'
 - Nail & K.C. remon. tag on E side P. pole N 40° E 120.28'
 - SW cor. hse. #5197 fndn. N 20° W 107.07'
 - NE cor. siding hse. #5180 S 60° W 160.60'
 - C/L of bit. road running E-W, South .5'
 - On fence line running S

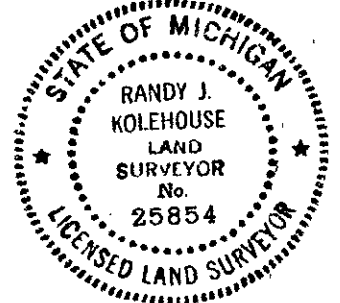

Signed by Randy J. Kolehouse

Date 3/30/99

Surveyor's Michigan License No. 25854