

\$7.00
\$2.00

MAY 22 2000

LAND CORNER RECORDATION CERTIFICATE
Filing Requirement of Act 74, Mich. P.A. 1970
KENT COUNTY REMONUMENTATION

SECTION

For corners in

Kent (County)	Located in: Courtland Township	Corner Code #
1. Public Land Survey	T 9N R 10W	B-5
	T R	
	T R	
	T R	
	T R	
2. Property Controlling in Section	S T R	
	S T R	
3. Miscellaneous Property in Sec.	S T R	
	S T R	

STATE OF MICHIGAN
COUNTY OF KENT
RECEIVED FOR RECORD

1999 OCT 15 AM 8:03


REG. OF DEEDS

11270

Register of Deeds Stamp & File Number

4. Lot No. _____, Recorded Plat _____
5. Private Claims _____

I, Randy Kolehouse, in a field survey on January 21, 19 99, do hereby certify that under requirements of P.A. 74 Michigan P.A. of 1970, the corner points mentioned in lines 1 and 2 above were in conformance with regulations and rules therefore as required in the current manual of survey instructions of the United States Department of the interior, Bureau of Land Management or by a decree of a Court of Law and/or that the corner points mentioned in lines 3, 4 and 5 above were in conformance with the rules of the Michigan Board of Land Surveyors or by a Decree of a Court of Law; established, re-established, monumented, re-monumented, recovered, found as expressed below:

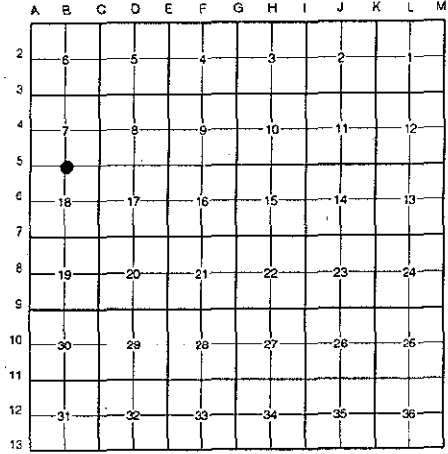

NOTE: Not more than 4 corners, all in the same town and range, may be recorded on this certificate.

A. Description of original monument and accessories and/or subsequent restoration:

B-5	1837	G.L.O. Notes	Cathcart	Set Post	P.A. 345 1990 KENT COUNTY PEER APPROVED 2/25/99 CHAIRMAN <i>Randy Kolehouse</i>
	1963	Witness Map	K.C. Surveyor	"T" Iron	
	1976	L.C.R.C. #924	J. McCloskey	"T" Iron	
	1978	L.C.R.C. #1189	Williams & Works	"T" Iron	
	1982	L.C.R.C. #2978	Jonker Land Survey	Fnd. "T" Iron in Mon. Box / Set K.C. Monument in Mon. Box	
	1988	L.C.R.C. #4794	Olson, Meyer & May	K.C. Monument in Mon. Box	

This corner was originally approved by the Kent County Remonumentation Peer Group and monumented by Rob Jonker on 7/7/82 and was recorded per L.C.R.C. #2978.

B. Description of corner evidence found and/or method applied in restoring or reestablishing corner:

B-5 Found a Standard Kent County Monument in a monument box 2.5' South of the C/L of 14 Mile Road (bit.) running East and West per L.C.R.C.'s #2978 and #4794 as set by Rob Jonker in place of a "T" iron he found in a monument box which checked L.C.R.C.'s #1189, #924 and the K.C. Surveyor's records.

L.C.R.C. #2978

L.C.R.C. #4794


Remon. tag on W side 20" W.Cherry N0°E 50.46'
Remon. tag on SW side 9" Oak N40°W 70.00'
Remon. tag on E side 9" Oak S20°E 49.90'
Remon. tag on NW side 10" Elm N60°E 86.33'
Capped iron south 39.95'
C/L E-W pavement N, 2.5'

Remon tag & nail on W sde 22" W. Cherry N 0 E 50.46' (m. 50.44')
Remon tag & nail on SW sde 11" Oak N 40 W 70.05' (m. 70.00')
Remon tag & nail on E sde 11" Oak S 20 E 49.94'
Remon tag & nail on NW sde 12" Elm N 60 E 86.27' (m. 86.47')
Capped iron S 39.95'
C/L E-W pavt. N, 2.5'

The selected location is accepted by me and is generally accepted by professional surveyors as the best available evidence of the position of the original corner.

C. Description of monument for corner and accessories established to perpetuate locating the position of the corner:

B-5 Standard Kent County Monument in a Monument Box
Nail & K.C. remon. tag on W side 22" W. Cherry North 50.44'
Nail & K.C. remon. tag on SW side 12" Oak N 40° W 70.00'
Nail & K.C. remon. tag on E side 12" Oak S 20° E 49.94'
Nail & K.C. remon. tag on NW side 12" Elm N 60° E 86.47'
Capped iron South 39.95'
C/L of bit. road running E-W, North 2.5'

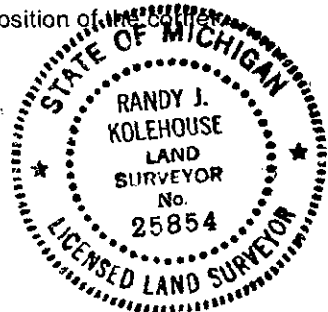

Signed by *Randy J. Kolehouse* Date 3/30/99

Surveyor's Michigan License No. 25854