

MAY 22 2000

\$7.00
\$2.00

LAND CORNER RECORDATION CERTIFICATE
Filing Requirement of Act 74, Mich. P.A. 1970
KENT COUNTY REMONUMENTATION

STATE OF MICHIGAN
COUNTY OF KENT
RECEIVED FOR RECORD
1999 OCT 15 AM 8:03

REG. OF DEEDS

SECTION

For corners in

Kent (County)	Located in:	Courtland Township	Corner Code #
1. Public Land Survey,	T <u>9N</u>	R <u>10W</u>	<u>B-6</u>
	T _____	R _____	_____
	T _____	R _____	_____
	T _____	R _____	_____
2. Property Controlling in Section	S _____	T _____	R _____
	S _____	T _____	R _____
3. Miscellaneous Property in Sec.	S _____	T _____	R _____
	S _____	T _____	R _____

11271

Register of Deeds Stamp & File Number

- 4. Lot No. _____, Recorded Plat _____
- 5. Private Claims _____

I, Randy Kolehouse, in a field survey on February 12 19 99, do hereby certify that under requirements of P.A. 74 Michigan P.A. of 1970, the corner points mentioned in lines 1 and 2 above were in conformance with regulations and rules therefore as required in the current manual of survey instructions of the United States Department of the interior, Bureau of Land Management or by a decree of a Court of Law and/or that the corner points mentioned in lines 3, 4 and 5 above were in conformance with the rules of the Michigan Board of Land Surveyors or by a Decree of a Court of Law; established, re-established, monumented, re-monumented, recovered, found as expressed below:

NOTE: Not more than 4 corners, all in the same town and range, may be recorded on this certificate.

A. Description of original monument and accessories and/or subsequent restoration:


B-6 This corner was not originally set by the G.L.O.

1903	Survey Records	Williams & Works	Old Stake
1967	Witness Map	K.C. Surveyor	Iron
1967	Survey Records	Williams & Works	Set "T" Iron
1978	L.C.R.C. #1189	John N. Mendzinski	"T" Iron

P.A. 345 1990 KENT COUNTY

PEER APPROVED 3/25/99

CHAIRMAN [Signature]

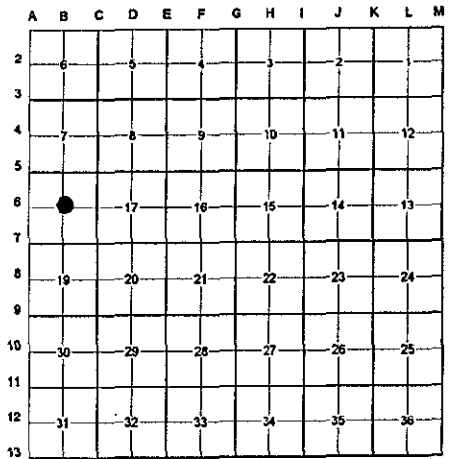

B. Description of corner evidence found and/or method applied in restoring or reestablishing corner:

B-6 Found a "T" iron on line of a fence line running North, South and East per L.C.R.C. #1189 as set by Williams & Works in 1967 which checked the K.C. Surveyor's records. The "T" iron is 0.3' North and 0.3' East of the intersection of 1/4 lines. Accepted the "T" iron as Center of Section.

K.C. Witness Map (1967)

16" Oak WNW 15.77' (face) (m. 16.76')
10" Oak E 16.09' (face) (m. 16.47')

L.C.R.C. #1189

12" Oak S.10°W. 35.45' (m. 35.46')
20" Oak N.70°W. 16.80' (m. 16.76')
12" Oak N.85°E. 32.73' (m. 32.72')
12" Oak S.60°E. 16.36' (m. 16.47')

The selected location is accepted by me and is generally accepted by professional surveyors as the best available evidence of the position of the original corner.

C. Description of monument for corner and accessories established to perpetuate locating the position of the corner:

B-6 Replaced "T" Iron with a Standard Kent County Monument

- Nail & K.C. remon. tag on W side 14" Oak S 10° W 35.46'
- Nail & K.C. remon. tag on S side 20" Oak N 70° W 16.76'
- Nail & K.C. remon. tag on N side 14" Oak N 85° E 32.72'
- Nail & K.C. remon. tag on S side 14" Oak S 60° E 16.47'
- Nail & K.C. remon. tag on E side 14" Oak N 00° E 25.32'
- On fence line running N-S & E



Signed by [Signature]
WILLIAMS & WORKS

Date 9-27-99

Surveyor's Michigan License No. 25854