

\$7.00
\$2.00

MAY 22 2000

LAND CORNER RECORDATION CERTIFICATE
Filing Requirement of Act 74, Mich. P.A. 1970
KENT COUNTY REMONUMENTATION

STATE OF MICHIGAN
COUNTY OF KENT
RECEIVED FOR RECORD
1999 OCT 15 AM 8:03

REG. OF DEEDS

11273

Register of Deeds Stamp & File Number

For corners in

SECTION

Kent (County)	Located in:	Courtland Township	Corner Code #
1. Public Land Survey	T <u>9N</u>	R <u>10W</u>	<u>B-9</u>
	T _____	R _____	_____
	T _____	R _____	_____
	T _____	R _____	_____
2. Property Controlling in Section	S _____	T _____	R _____
	S _____	T _____	R _____
3. Miscellaneous Property in Sec.	S _____	T _____	R _____
	S _____	T _____	R _____

4. Lot No. _____, Recorded Plat _____
5. Private Claims _____

I, Randy Kolehouse, in a field survey on January 7 19 99, do hereby certify that under requirements of P.A. 74 Michigan P.A. of 1970, the corner points mentioned in lines 1 and 2 above were in conformance with regulations and rules therefore as required in the current manual of survey instructions of the United States Department of the interior, Bureau of Land Management or by a decree of a Court of Law and/or that the corner points mentioned in lines 3, 4 and 5 above were in conformance with the rules of the Michigan Board of Land Surveyors or by a Decree of a Court of Law, established, re-established, monumented, re-monumented, recovered, found as expressed below:


NOTE: Not more than 4 corners, all in the same town and range, may be recorded on this certificate.

A. Description of original monument and accessories and/or subsequent restoration:

B-9	1837	G.L.O. Notes	Cathcart	Set Post
	1965	Witness Map	K.C. Surveyor	Iron in Monument Box
	1980	L.C.R.C. #1380	G. Hackbardt	Monument Box
	1982	L.C.R.C. #2987	Jonker Land Survey	Fnd. 3/4" Iron in Mon. Box / Set K.C. Monument
	1988	L.C.R.C. #4796	Olson, Meyer & May	K.C. Monument

P.A. 345 1990 KENT COUNTY.

PEER APPROVED 2/25/99
CHAIRMAN Randy Kolehouse

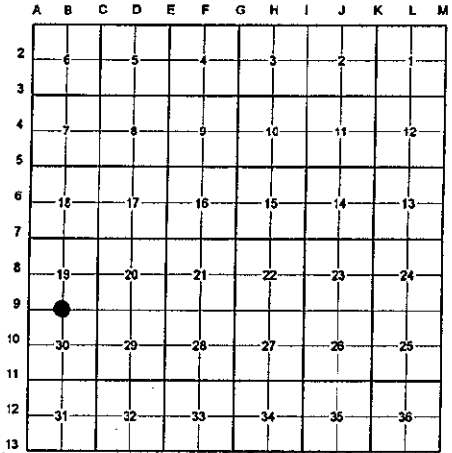

This corner was originally approved by the Kent County Remonumentation Peer Group and monumented by Rob Jonker on 7/9/82 and was recorded per L.C.R.C. #2987.

B. Description of corner evidence found and/or method applied in restoring or reestablishing corner:

B-9 Found a Standard Kent County Monument on the C/L of 12 Mile Road (bit.) running East and West, on line of a tree row running North and South, per L.C.R.C.'s #2987 and #4796 as set by Rob Jonker in place of a 3/4" iron he found in a monument box which checked L.C.R.C. #1380 and the K.C. Surveyor's records.

L.C.R.C. #2987

Remon. tag on E side 5" Oak N20°E 32.05'
Remon. tag on E side 24" Oak S35°E 29.05'
Remon. tag on NE side 4" Hickory S45°E 74.74'
Remon. tag on S side fe.post N80°E 126.04'
On C/L E-W pavement
On N-S tree lines

L.C.R.C. #4796


Nail on E side 7" Oak N 20 E 32.05' (m. 32.15')
Nail on E side 26" Oak S 35 W 29.05' (m. 29.04')
Remon tag & nail on NE side 6" Hickory S 45 E 74.60' (m. 74.68')
Remon tag & nail on S side fence post N 80 E 126.04'
On C/L E-W pavt.
On N-S tree lines

The selected location is accepted by me and is generally accepted by professional surveyors as the best available evidence of the position of the original corner.

C. Description of monument for corner and accessories established to perpetuate locating the position of the corner:

B-9 Standard Kent County Monument

Nail & K.C. remon. tag on E side 12" Oak N 20° E 32.15'
Nail & K.C. remon. tag on E side 32" Oak S 35° W 29.04'
Nail & K.C. remon. tag on NE side 8" Hickory S 45° E 74.68'
Nail & K.C. remon. tag on S side fence post N 80° E 126.04'
Nail & K.C. remon. tag on SW side 12" Pine N 60° W 79.10'
On C/L of bit. road running E-W
On tree row running N-S

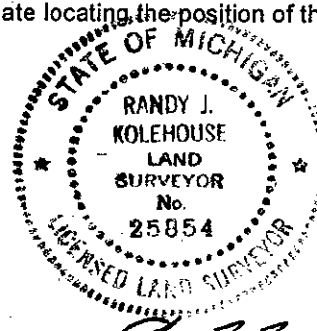

Signed by Randy J. Kolehouse

Date 9-27-99

WILLIAMS & WORKS

Surveyor's Michigan License No. 25854