

MAY 22 2000

\$7.00
\$2.00

SECTION

LAND CORNER RECORDATION CERTIFICATE
Filing Requirement of Act 74, Mich. P.A. 1970
KENT COUNTY REMONUMENTATION

For corners in

Kent (County)	Located in:	Courtland Township	Corner Code #
1. Public Land Survey	T <u>9N</u>	R <u>10W</u>	<u>B-10</u>
	T _____	R _____	_____
	T _____	R _____	_____
	T _____	R _____	_____
2. Property Controlling in Section	S _____	T _____	R _____
	S _____	T _____	R _____
3. Miscellaneous Property in Sec.	S _____	T _____	R _____
	S _____	T _____	R _____

REG. OF DEEDS

[Signature]


STATE OF MICHIGAN
COUNTY OF KENT
RECEIVED FOR RECORD
1999 OCT 15 AM 8:03

11274

Register of Deeds Stamp & File Number

4. Lot No. _____, Recorded Plat _____
5. Private Claims _____

I, Randy Kolehouse, in a field survey on March 16 19 99, do hereby certify that under requirements of P.A. 74 Michigan P.A. of 1970, the corner points mentioned in lines 1 and 2 above were in conformance with regulations and rules therefore as required in the current manual of survey instructions of the United States Department of the interior, Bureau of Land Management or by a decree of a Court of Law and/or that the corner points mentioned in lines 3, 4 and 5 above were in conformance with the rules of the Michigan Board of Land Surveyors or by a Decree of a Court of Law; established, re-established, monumented, re-monumented, recovered, found as expressed below:

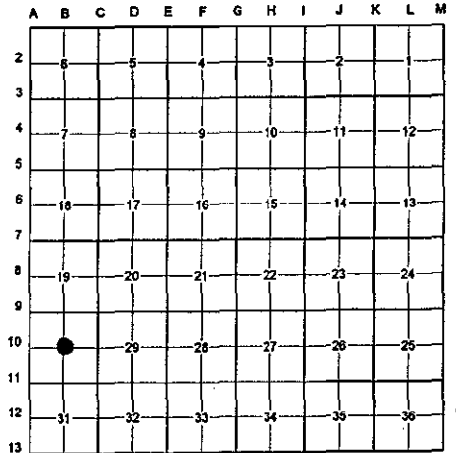

NOTE: Not more than 4 corners, all in the same town and range, may be recorded on this certificate.

A. Description of original monument and accessories and/or subsequent restoration:

B-10 This corner was not originally set by the G.L.O.

1947	Survey Records	Williams & Works	Old Fence Corner
1966	Survey Records	Williams & Works	Set Iron at "True Center"
1981	L.C.R.C. #3561	Medema, Van Kooten & Assoc.	Set Iron at Intersection of 1/4 Lines

B. Description of corner evidence found and/or method applied in restoring or reestablishing corner:

B-10 Iron set by Medema, Van Kooten and Associates at the intersection of 1/4 lines has been lost due to a tree near the iron being blown over. Reset a point at the intersection of 1/4 lines. This point checks the Medema-Van Kooten survey measurements N-S and E-W to the opposite 1/4 corner $\pm 0.5'$. Also checks Williams & Works survey measurements to West 1/4 corner $\pm 1.5'$ and to South 1/4 corner $\pm 0.6'$. Accepted point set at this intersection of 1/4 lines as Center of Section.


P.A. 345 1990 KENT COUNTY
PEER APPROVED 2/25/99
CHAIRMAN [Signature]

The selected location is accepted by me and is generally accepted by professional surveyors as the best available evidence of the position of the original corner.

C. Description of monument for corner and accessories established to perpetuate locating the position of the corner:

B-10 Set a Standard Kent County Monument

- Nail & K.C. remon. tag on S side 22" Poplar N 55° W 19.99'
- Nail & K.C. remon. tag on E side 12" Elm South 42.09'
- Nail & K.C. remon. tag on N side 12" Maple S 80° E 20.27'
- Nail & K.C. remon. tag on SW side 6" Oak S 35° E 41.09'

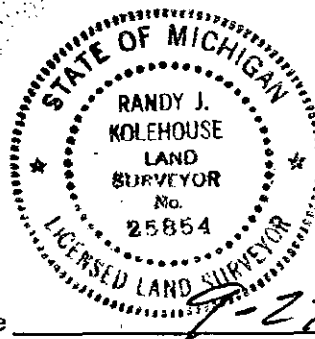

Signed by [Signature] Date 2-27-99
WILLIAMS & WORKS
Surveyor's Michigan License No. 25854