

\$7.00
\$2.00

MAY 22 2000

SECTION

LAND CORNER RECORDATION CERTIFICATE
Filing Requirement of Act 74, Mich. P.A. 1970
KENT COUNTY REMONUMENTATION

For corners in

Kent (County)	Located in:	Courtland Township	Corner Code #
1. Public Land Survey	T	9N R 10W	B-11
	T	R	
	T	R	
	T	R	
2. Property Controlling in Section	S	T R	
	S	T R	
3. Miscellaneous Property in Sec.	S	T R	
	S	T R	

1999 OCT 15 AM 8:03
STATE OF MICHIGAN
COUNTY OF KENT
RECEIVED FOR RECORD
REG. OF DEEDS


11275

Register of Deeds Stamp & File Number

4. Lot No. _____, Recorded Plat _____
5. Private Claims _____

I, Randy Kolehouse, in a field survey on January 5 19 99, do hereby certify that under requirements of P.A. 74 Michigan P.A. of 1970, the corner points mentioned in lines 1 and 2 above were in conformance with regulations and rules therefore as required in the current manual of survey instructions of the United States Department of the interior, Bureau of Land Management or by a decree of a Court of Law and/or that the corner points mentioned in lines 3, 4 and 5 above were in conformance with the rules of the Michigan Board of Land Surveyors or by a Decree of a Court of Law; established, re-established, monumented, re-monumented, recovered, found as expressed below:

NOTE: Not more than 4 corners, all in the same town and range, may be recorded on this certificate.

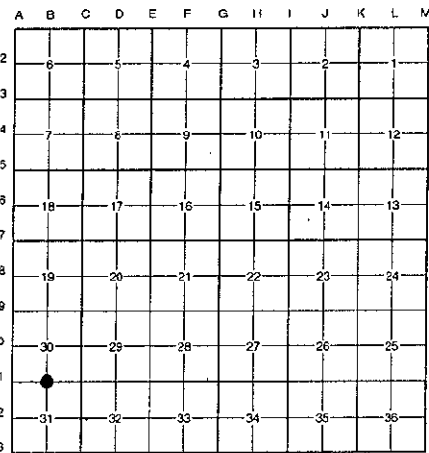

A. Description of original monument and accessories and/or subsequent restoration:

B-11	1837	G.L.O. Notes	Cathcart	Set Post
	1942	Witness Map	K.C. Surveyor	RR Spike
	1971	L.C.R.C. #79	Williams & Works	RR Spike
	1982	L.C.R.C. #2973	Jonker Land Survey	Fnd. RR Spike / Set K.C. Monument
	1988	L.C.R.C. #4797	Olson, Meyers, & May	K.C. Monument

P.A. 345 1990 KENT COUNTY

PEER APPROVED 2/25/99

CHAIRMAN Randy Kolehouse

This corner was originally approved by the Kent County Remonumentation Peer Group and monumented by Jonker Land Survey on 7/12/82 and was recorded per L.C.R.C. #2973.

B. Description of corner evidence found and/or method applied in restoring or reestablishing corner:

B-11 Found a Standard Kent County Monument 1.0' ± South of the C/L of 11 Mile Road (bit.) running East and West and 12.0' ± West of the C/L entrance to Wolverine World Wide Factory parking area per L.C.R.C.'s #2973 and #4797 as set by Rob Jonker in place of a RR spike he found at grade over a 4" x 24" concrete monument 18" below grade which checked L.C.R.C. #79 and the K.C. Surveyor's records.

L.C.R.C. #2973

L.C.R.C. #4797


C/L SW bolt on lightbase N45°W 41.98'	C/L SW bolt on lightbase N 20° W 41.98' (m. 41.76')
Remon. tag on NW side 10" Hickory S60°W 47.02'	Remon tag & nail on NW sde 12" Hickory S 60° W 47.02' (m. 46.95')
Remon. tag on N side 36" Oak S70°E 109.26'	Remon tag & nail on N sde 38" Oak S 70° E 109.21' (m. 109.21')
NW corner garage brick S10°E 80.54'	NW cor garage brick S 10° E 80.54' (m. 80.58')
NE corner house brick S45°E 111.75'	NE cor hse brick S 45° E 111.75' (m. 111.80')
	C/L E-W pavt. N 1' M/L
	Cor is W 12' M/L from C/L E ent. To Wolverine World Wide Factory Parking Area

The selected location is accepted by me and is generally accepted by professional surveyors as the best available evidence of the position of the original corner.

C. Description of monument for corner and accessories established to perpetuate locating the position of the corner:

B-11 Standard Kent County Monument

- C/L SW bolt on lightbase N 20° W 41.76'
- Nail & K.C. remon. tag on NW side 12" Hickory S 60° W 46.95'
- Nail & K.C. remon. tag on N side 38" Oak S 70° E 109.21'
- NW cor. garage brick S 10° E 80.58'
- NE cor. hse. Brick S 45° E 111.80'
- C/L of bit. road running E-W, North 1.0' ±
- C/L entrance to Wolverine World Wide Factory, East 12.0' ±

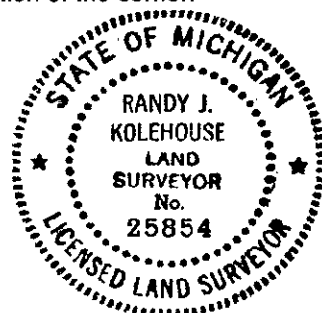

Signed by Randy Kolehouse

Date 3/30/99

Surveyor's Michigan License No. 25854