

\$7.00
\$2.00

MAY 22 2000

LAND CORNER RECORDATION CERTIFICATE
Filing Requirement of Act 74, Mich. P.A. 1970
KENT COUNTY REMONUMENTATION

For corners in

SECTION

Kent (County)	Located in: Courtland Township	Corner Code #
1. Public Land Survey	T 9N R 10W	B-12
	T R	
	T R	
	T R	
2. Property Controlling in Section	S T R	
	S T R	
3. Miscellaneous Property in Sec.	S T R	
	S T R	

REG. OF DEEDS

[Signature]

STATE OF MICHIGAN
COUNTY OF KENT
RECEIVED FOR RECORD
1999 OCT 15 AM 8:03


11276

Register of Deeds Stamp & File Number

4. Lot No. _____, Recorded Plat _____
5. Private Claims _____

I, Randy Kolehouse, in a field survey on January 11 19 99, do hereby certify that under requirements of P.A. 74 Michigan P.A. of 1970, the corner points mentioned in lines 1 and 2 above were in conformance with regulations and rules therefore as required in the current manual of survey instructions of the United States Department of the interior, Bureau of Land Management or by a decree of a Court of Law and/or that the corner points mentioned in lines 3, 4 and 5 above were in conformance with the rules of the Michigan Board of Land Surveyors or by a Decree of a Court of Law; established, re-established, monumented, re-monumented, recovered, found as expressed below:

NOTE: Not more than 4 corners, all in the same town and range, may be recorded on this certificate.

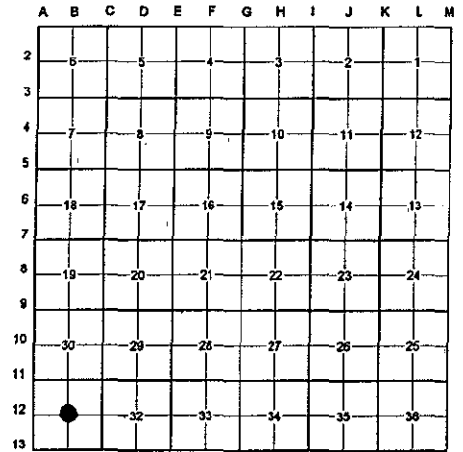

A. Description of original monument and accessories and/or subsequent restoration:

B-12 This corner was not originally set by the G.L.O.

1963	Witness Map	K.C. Surveyor	Iron (per Medema, Van Kooten & Associates)
1984	Cert. Survey L. 160 P. 5	All Points	3/4" Iron
1994	Cert. Survey L. 266 P. 19	Exxel Engineering	3/4" Iron

P.A. 345 1990 KENT COUNTY
PEER APPROVED 2/25/99
CHAIRMAN *[Signature]*

B. Description of corner evidence found and/or method applied in restoring or reestablishing corner:

B-12 Found a 3/4" iron pipe on line of a tree row running North and East, 8.0' West of a fence line running North and 7.0' North of a fence line running West. Found iron checks witnesses from Witness Map (1963) and Cert. Surveys L. 160 P. 5 and L. 266 P. 19. The 3/4" iron is 6.6' West of the intersection of 1/4 lines. Accepted 3/4" iron as Center of Section.

Witness Map (1963)

34" Oak NE 16.2' (m. 17.05' C/L)
14" Oak E 20.5' (m. 21.45' C/L)
Fen. Cor. 8' E and 7' S

Cert. Survey L. 266 P. 19


C/L 15" Oak WNW 33.5' (m. 33.35')
Nail 16" Tw. Oak ENE 17.03' (m. 17.05')
Nail 20" Tw. Oak E 21.45'

The selected location is accepted by me and is generally accepted by professional surveyors as the best available evidence of the position of the original corner.

C. Description of monument for corner and accessories established to perpetuate locating the position of the corner:

B-12 Replaced 3/4" Iron with a Standard Kent County Monument

Nail & K.C. remon. tag on SE side 36" Twin Oak N 60° E 17.05'
Nail & K.C. remon. tag on N side 20" Oak N 90° E 21.45'
Nail & K.C. remon. tag on N side 12" Oak S 72° W 32.95'
Nail & K.C. remon. tag on N side 18" Oak N 65° W 33.35'
Nail & K.C. remon. tag on E side 10" Oak N 12° E 41.33'
On tree row running N and E
Fence line running N, East 8.0'
Fence line running W, South 7.0'

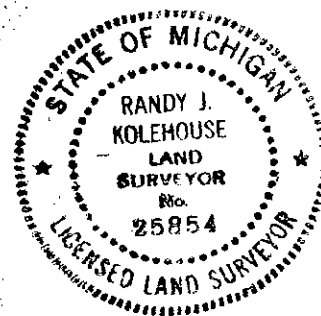

Signed by *[Signature]* Date 9-27-99

WILLIAMS & WORKS

Surveyor's Michigan License No. 25854