

**SURVEY & REMONUMENTATION**

MAR 03 1998

\$7.00  
\$2.00

**LAND CORNER RECORDATION CERTIFICATE**  
Filing Requirement of Act 74, Mich. P.A. 1970  
KENT COUNTY REMONUMENTATION

STATE OF MICHIGAN  
COUNTY OF KENT  
RECEIVED FOR RECORD  
97 NOV 14 AM 9:01  
REG. OF DEEDS  
*Luci Storch*

**SECTION**

For corners in

Kent (County)	Located in: Courtland Township	Corner Code #
1. Public Land Survey	T <u>9N</u> R <u>10W</u>	<u>B-13</u>
	T _____ R _____	_____
	T _____ R _____	_____
	T _____ R _____	_____
2. Property Controlling in Section	S _____ T _____ R _____	_____
	S _____ T _____ R _____	_____
3. Miscellaneous Property in Sec.	S _____ T _____ R _____	_____
	S _____ T _____ R _____	_____
4. Lot No. _____, Recorded Plat _____		
5. Private Claims _____		


**10319**  
Register of Deeds Stamp & File Number

I, Randy Kolehouse, in a field survey on July 14 19 97, do hereby certify that under requirements of P.A. 74 Michigan P.A. of 1970, the corner points mentioned in lines 1 and 2 above were in conformance with regulations and rules therefore as required in the current manual of survey instructions of the United States Department of the Interior, Bureau of Land Management or by a decree of a Court of Law and/or that the corner points mentioned in lines 3, 4 and 5 above were in conformance with the rules of the Michigan Board of Land Surveyors or by a Decree of a Court of Law; established, re-established, monumented, re-monumented, recovered, found as expressed below:

**NOTE: Not more than 4 corners, all in the same town and range, may be recorded on this certificate.**

**A. Description of original monument and accessories and/or subsequent restoration:**

B-13	1831	G.L.O. Notes	Mullett	Set Post
	1965	Witness Map	K.C. Surveyor	"T" Iron
	1973	L.C.R.C. #455	Medema, Van Kooten & Assoc.	Iron in Mon. Box
	1981	L.C.R.C. #1722	Williams & Works	Fnd. 1/2" Iron Pipe in Mon. Box / Set K.C. Monument
	1988	L.C.R.C. #4798	Olson, Meyers & May	K.C. Monument

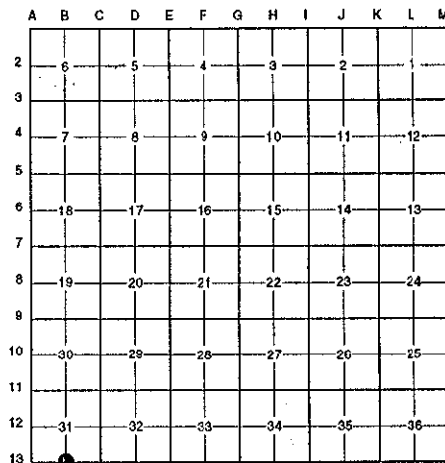

Note: This corner is not common with B-1, T8N, R10W.

This corner was originally approved by the Kent County Remonumentation Peer Group and monumented by Williams & Works on 1/13/81 and was recorded per L.C.R.C. #1722.

**B. Description of corner evidence found and/or method applied in restoring or reestablishing corner:**

B-13 Found a Standard Kent County Monument in a monument box on the C/L of 10 Mile Road (bit.) running East and West and 8' ± West of the C/L of Courtland Road (bit.) running South per L.C.R.C.'s #1722 and #4798 as set by Williams & Works in place of a 1/2" iron pipe they found in a monument box which checked L.C.R.C. #455 and the K.C. Surveyor's records.

L.C.R.C. #1722

L.C.R.C. #4798

K.C. Remon. Tag & Nail in SE Side P. Pole S 70°W 77.58'  
K.C. Remon. Tag & Nail in W Side P. Pole S 45°E 51.74'  
K.C. Remon. Tag & Nail in W Side 6" Twin Oak S 15°W 140.41'  
SW Cor. Hse. Fnd. N 75°E 166.63'  
SE Cor. Brick Face to Hse. N 00°E 109.02'  
SW Cor. Brick Face to Gar. N 30°W 134.71'  
C/L Man Hole Cover N 90°E 6.36'  
Iron in Mon. Box N 90°E 184.82'

K.C. Remon tag & nail in SE sde P Pole S 70 W 77.68'  
K.C. Remon tag & nail in W sde P Pole S 45 E 51.74'  
K.C. Remon tag & nail in W sde 8" Twin Oak S 15 W 140.41'  
SW cor hse fndn N 75 E 166.63'  
SE cor brick face to hse N 0 E 109.02'  
SW cor brick face to garage N 30 W 134.71'  
C/L manhole cover N 90 E 6.36'  
K.C. Mon in Mon Box N 90 E 184.82'


The selected location is accepted by me and is generally accepted by professional surveyors as the best available evidence of the position of the original corner.

**C. Description of monument for corner and accessories established to perpetuate locating the position of the corner:**

B-13 Standard Kent County Monument in a Monument Box

Nail & K.C. remon. tag on SE side P. pole S 70° W 77.68'  
Nail & K.C. remon. tag on W side P. pole S 45° E 51.74'  
Nail & K.C. remon. tag on W side Twin Stump S 15° W 140.41'  
SE cor. brick face to hse. #5191 N 00° E 109.02'  
C/L manhole cover N 90° E 6.36'  
K.C. Mon., B-1, T8N, R10W, East 184.82'

P.A. 345 1990 KENT COUNTY  
PEER APPROVED 7/29/97  
CHAIRMAN *Randy Kolehouse*

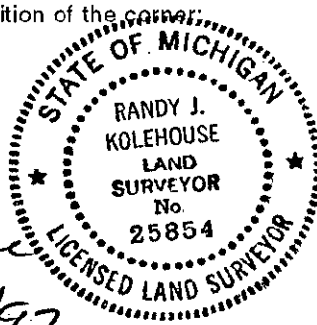

Signed by *Randy J. Kolehouse* Date 9/23/97

Surveyor's Michigan License No. 25854