

MAY 22 2000

\$7.00
\$2.00

SECTION

LAND CORNER RECORDATION CERTIFICATE
Filing Requirement of Act 74, Mich. P.A. 1970
KENT COUNTY REMONUMENTATION

For corners in

Kent (County)	Located in:	Courtland Township	Corner Code #
1. Public Land Survey	T <u>9N</u>	R <u>10W</u>	<u>C-2</u>
	T _____	R _____	_____
	T _____	R _____	_____
	T _____	R _____	_____
2. Property Controlling in Section	S _____	T _____	R _____
	S _____	T _____	R _____
3. Miscellaneous Property in Sec.	S _____	T _____	R _____
	S _____	T _____	R _____

REG. OF DEEDS

[Handwritten Signature]


STATE OF MICHIGAN
COUNTY OF KENT
RECEIVED FOR RECORD
1999 OCT 15 AM 8:03

11278
Register of Deeds Stamp & File Number

- 4. Lot No. _____, Recorded Plat _____
- 5. Private Claims _____

I, Randy Kolehouse, in a field survey on February 18 19 99, do hereby certify that under requirements of P.A. 74 Michigan P.A. of 1970, the corner points mentioned in lines 1 and 2 above were in conformance with regulations and rules therefore as required in the current manual of survey instructions of the United States Department of the interior, Bureau of Land Management or by a decree of a Court of Law and/or that the corner points mentioned in lines 3, 4 and 5 above were in conformance with the rules of the Michigan Board of Land Surveyors or by a Decree of a Court of Law; established, re-established, monumented, re-monumented, recovered, found as expressed below:

NOTE: Not more than 4 corners, all in the same town and range, may be recorded on this certificate.

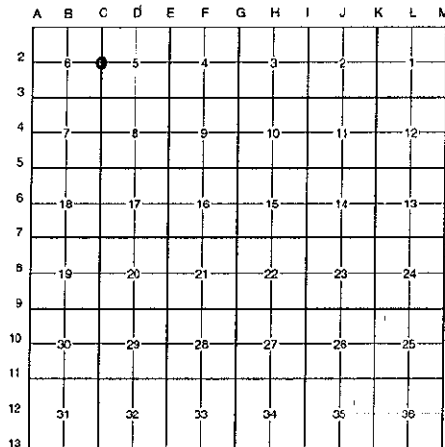

A. Description of original monument and accessories and/or subsequent restoration:

C-2	1837	G.L.O. Notes	Cathcart	Set Post
	1965	Witness Map	K.C. Surveyor	Iron & Stone
	1971	Notes	MDSH	1-1/2" Iron
	1973	Notes	Consumers Power Co.	3/4" Iron
	1995	L.C.R.C. #8711	Kirk Breitels	Fnd. Rerod / Set K.C. Monument

This corner was originally approved by the Kent County Remonumentation Peer Group and monumented by Kirk Breitels on 8/15/95 and was recorded per L.C.R.C. #8711.

B. Description of corner evidence found and/or method applied in restoring or reestablishing corner:

C-2 Found a Standard Kent County Monument at the C/L intersection of Ritchie Avenue (bit.) running North and South and Indian Lakes Road (gravel) running West, on line of a fence line running East, per L.C.R.C. #8711 as set by Kirk Breitels in place of rerod he found inside an iron pipe over top of a stone which checked the 1971 notes of MDSH, the 1973 notes of CPC, and the K.C. Surveyor's records.

L.C.R.C. #8711


- Nail & KC Remon. tag N. side 20" Hickory S70°W 93.83' (m. 93.78')
- Nail & KC Remon. tag W. side 40" maple S20°E 85.80'
- Nail & KC Remon. tag S. side wood fence post S90°E 33.01'
- Nail & KC Remon. tag W. side Power Pole S20°EW 171.23' (m. 171.27')
- SE cor. garage fnd. N45°W 155.62' (m. 155.64')

P.A. 345 1000 KENT COUNTY
PEER APPROVED 2/25/99
CHAIRMAN [Handwritten Signature]

The selected location is accepted by me and is generally accepted by professional surveyors as the best available evidence of the position of the original corner.

C. Description of monument for corner and accessories established to perpetuate locating the position of the corner:

- C-2 Standard Kent County Monument
- Nail & K.C. remon. tag on N side 20" Hickory S 70° W 93.78'
- Nail & K.C. remon. tag on W side 40" Maple S 20° E 85.80'
- Nail & K.C. remon. tag on S side wood fence post S 90° E 33.01'
- Nail & K.C. remon. tag on W side P. pole S 20° W 171.27'
- SE cor. garage fndn. N 45° W 155.64'
- On C/L "X" of bit. road running N-S and gravel road running W
- On fence line running E

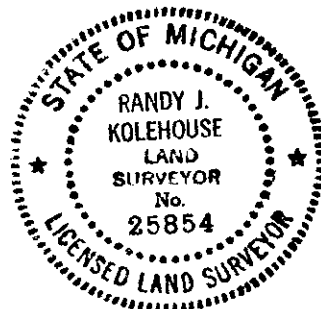

Signed by [Handwritten Signature]
EARTH TECH

Date 3/30/99

Surveyor's Michigan License No. 25854