

MAY 22 2000

\$7.00
\$2.00

SECTION

LAND CORNER RECORDATION CERTIFICATE
Filing Requirement of Act 74, Mich. P.A. 1970
KENT COUNTY REMONUMENTATION

For corners in

Kent (County)	Located in:	Courtland Township	Corner Code #
1. Public Land Survey	T <u>9N</u>	R <u>10W</u>	<u>C-3</u>
	T _____	R _____	_____
	T _____	R _____	_____
	T _____	R _____	_____
2. Property Controlling in Section	S _____	T _____	R _____
	S _____	T _____	R _____
3. Miscellaneous Property in Sec.	S _____	T _____	R _____
	S _____	T _____	R _____

REG. OF DEEDS

[Signature]


STATE OF MICHIGAN
COUNTY OF KENT
RECEIVED FOR RECORD
1999 OCT 15 AM 8:03

11279

Register of Deeds Stamp & File Number

4. Lot No. _____, Recorded Plat _____
5. Private Claims _____

I, Randy Kolehouse, in a field survey on January 25 19 99, do hereby certify that under requirements of P.A. 74 Michigan P.A. of 1970, the corner points mentioned in lines 1 and 2 above were in conformance with regulations and rules therefore as required in the current manual of survey instructions of the United States Department of the interior, Bureau of Land Management or by a decree of a Court of Law and/or that the corner points mentioned in lines 3, 4 and 5 above were in conformance with the rules of the Michigan Board of Land Surveyors or by a Decree of a Court of Law; established, re-established, monumented, re-monumented, recovered, found as expressed below:

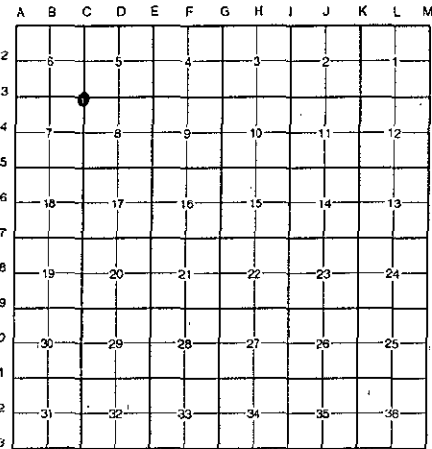

NOTE: Not more than 4 corners, all in the same town and range, may be recorded on this certificate.

A. Description of original monument and accessories and/or subsequent restoration:

C-3	1837	G.L.O. Notes	Cathcart	Set Post	P.A. 345 1990 KENT COUNTY
	1966	Witness Map	K.C. Surveyor	Iron	PEER APPROVED <u>2/25/99</u>
	1983	L.C.R.C. #3414	Glaza & Associates	N/A	<i>[Signature]</i>
	1984	L.C.R.C. #4017	John Bueche	Fnd. Iron in Mon. Box / Set K.C. Monument in Mon. Box	CHAIRMAN
	1988	L.C.R.C. #4799	John Bueche	K.C. Monument in a Mon. Box	

This corner was originally approved by the Kent County Remonumentation Peer Group and monumented by John Bueche on 11/7/84 and was recorded per L.C.R.C. #4017.

B. Description of corner evidence found and/or method applied in restoring or reestablishing corner:

C-3 Found a Standard Kent County Monument in a monument box at the C/L intersection of 15 Mile Road (bit.) running East and West and Ritchie Avenue (bit.) running North (gravel) running South per L.C.R.C.'s #4017 and #4799 as set by John Bueche in place of an iron he found in a monument box which checked L.C.R.C. #3414 and the K.C. Surveyor's records.

L.C.R.C. #4017

L.C.R.C. #4799

"X" cut in conc. culvt. N. 70° W 105.04'
 "X" cut in conc. culvt. S. 80° W 106.63'
 K.C. Mon. tag & nail in E. side Power Pole S 20° W 149.97'
 K.C. Mon. tag & nail in W. side fence post S 20° E 51.08'
 K.C. Mon. tag & nail in N. side fence post S 45° E 45.13'
 K.C. Mon. Tag & nail in NE side fence post S 65° E 87.90'
 C/L blacktop N-S & E-W

"X" cut in conc culvt. N 70 W 105.04' (m. 105.10')
 "X" cut in conc culvt. S 80 W 106.63' (m. 106.85')
 K.C. Mon tag & nail in E sde P pole S 20 W 149.97' (m. 149.85')
 K.C. Mon tag & nail in W sde fence post S 20 E 51.08' (m. 51.01')
 K.C. Mon tag & nail in N sde fence post S 45 E 45.13' (m. 45.12')
 K.C. Mon tag & nail in NE sde fence post S 65 E 87.90' (m. 87.87')
 C/L bit N-S & E-W

The selected location is accepted by me and is generally accepted by professional surveyors as the best available evidence of the position of the original corner.

C. Description of monument for corner and accessories established to perpetuate locating the position of the corner:

C-3 Standard Kent County Monument in a Monument Box

"X" cut N end conc. culvert N 70° W 105.10'
 "X" cut S end conc. culvert S 80° W 106.85'
 Nail & K.C. remon. tag on E side P. pole S 20° W 149.85'
 Nail & K.C. remon. tag on W side fence post S 20° E 51.01'
 Nail & K.C. remon. tag on N side fence post S 45° E 45.12'
 Nail & K.C. remon. tag on N side fence post S 65° E 87.87'
 C/L "X" of bit. roads running N-W-E and gravel road running South



Signed by *[Signature]*

EARTH TECH

Date 3/30/99

Surveyor's Michigan License No. 25854