

\$7.00
\$2.00

MAY 22 2000

SECTION

LAND CORNER RECORDATION CERTIFICATE
Filing Requirement of Act 74, Mich. P.A. 1970
KENT COUNTY REMONUMENTATION

For corners in

Kent (County)	Located in: Courtland Township	Corner Code #
1. Public Land Survey	T <u>9N</u> R <u>10W</u>	<u>C-6</u>
	T _____ R _____	_____
	T _____ R _____	_____
	T _____ R _____	_____
2. Property Controlling in Section	S _____ T _____ R _____	_____
	S _____ T _____ R _____	_____
3. Miscellaneous Property in Sec.	S _____ T _____ R _____	_____
	S _____ T _____ R _____	_____

REG. OF DEEDS

[Signature]

STATE OF MICHIGAN
COUNTY OF KENT
RECEIVED FOR RECORD
1999 OCT 15 AM 8:03

11281

Register of Deeds Stamp & File Number

- 4. Lot No. _____, Recorded Plat _____
- 5. Private Claims _____


I, Randy Kolehouse, in a field survey on February 12 19 99, do hereby certify that under requirements of P.A. 74 Michigan P.A. of 1970, the corner points mentioned in lines 1 and 2 above were in conformance with regulations and rules therefore as required in the current manual of survey instructions of the United States Department of the interior, Bureau of Land Management or by a decree of a Court of Law and/or that the corner points mentioned in lines 3, 4 and 5 above were in conformance with the rules of the Michigan Board of Land Surveyors or by a Decree of a Court of Law; established, re-established, monumented, re-monumented, recovered, found as expressed below:

NOTE: Not more than 4 corners, all in the same town and range, may be recorded on this certificate.

A. Description of original monument and accessories and/or subsequent restoration:

C-6	1837	G.L.O. Notes	Cathcart	Set Post
	1967	Witness Map	K.C. Surveyor	Iron
	1978	L.C.R.C. #1189	Williams & Works	"T" Iron
	1982	L.C.R.C. #2981	Jonker Land Survey	Fnd. "T" Iron / Set K.C. Monument
	1988	L.C.R.C. #4801	John Bueche	K.C. Monument

P.A. 345 1990 KENT COUNTY
PEER APPROVED 2/25/99
CHAIRMAN [Signature]

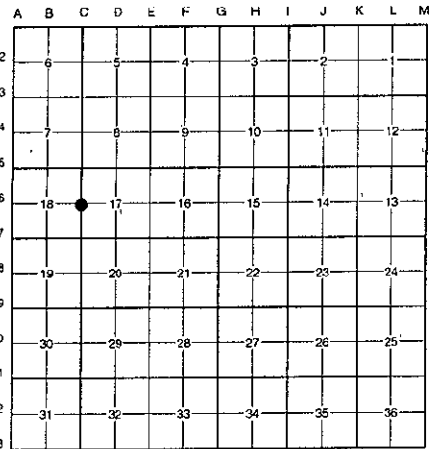

This corner was originally approved by the Kent County Remonumentation Peer Group and monumented by Rob Jonker on 7/7/82 and was recorded per L.C.R.C. #2981.

B. Description of corner evidence found and/or method applied in restoring or reestablishing corner:

C-6 Found a Standard Kent County Monument on the Northeast side of a corner post for fences running North, South, East and West per L.C.R.C.'s #2981 and #4801 as set by Rob Jonker in place of a "T" iron he found which checked L.C.R.C. #1189 and the K.C. Surveyor's records.

L.C.R.C. #2981

- Remon. tag on W side 12" Maple S10°W 15.92'
- Remon. tag on S side 24" Oak N65°W 25.22'
- Remon. tag on NE side 20" Oak S60°E 42.10'
- Remon. tag on S side 14" Maple N85°E 49.60'
- Remon. tag on E side 16" Oak N0°E 35.8'

L.C.R.C. #4801


- Remon tag & nail on W sde 14" Maple S 10 W 15.92' (m. 15.96')
- Remon tag & nail on S sde 26" Oak N 65 W 25.16' (m. 25.26')
- Remon tag & nail on NE sde 22" Oak S 60 E 42.03'
- Remon tag & nail on S sde 16" Maple N 85 E 49.64' (m. 49.53')
- Remon tag & nail on E sde 18" Oak N 0 E 35.8' (m. 35.91')

The selected location is accepted by me and is generally accepted by professional surveyors as the best available evidence of the position of the original corner.

C. Description of monument for corner and accessories established to perpetuate locating the position of the corner:

C-6 Standard Kent County Monument

- Nail & K.C. remon. tag on W side 14" Maple S 10° W 15.96'
- Nail & K.C. remon. tag on S side 26" Oak N 65° W 25.26'
- Nail & K.C. remon. tag on NE side 22" Oak S 60° E 42.03'
- Nail & K.C. remon. tag on S side 16" Maple N 85° E 49.53'
- Nail & K.C. remon. tag on E side 18" Oak North 35.91'

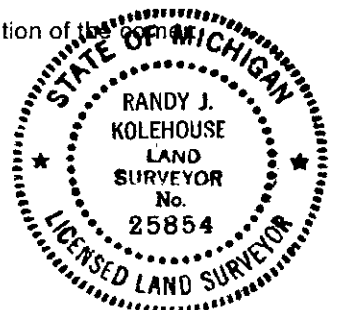

Signed by Randy J. Kolehouse
EARTH TECH

Date 3/30/99

Surveyor's Michigan License No. 25854