

MAY 22 2000

\$7.00
\$2.00

SECTION

LAND CORNER RECORDATION CERTIFICATE
Filing Requirement of Act 74, Mich. P.A. 1970
KENT COUNTY REMONUMENTATION

For corners in

Kent (County)	Located in: Courtland Township	Corner Code #
1. Public Land Survey	T <u>9N</u> R <u>10W</u>	<u>C-9</u>
	T _____ R _____	_____
	T _____ R _____	_____
	T _____ R _____	_____
2. Property Controlling in Section	S _____ T _____ R _____	_____
	S _____ T _____ R _____	_____
3. Miscellaneous Property in Sec.	S _____ T _____ R _____	_____
	S _____ T _____ R _____	_____

REG. OF DEEDS

[Signature]

STATE OF MICHIGAN
COUNTY OF KENT
RECEIVED FOR RECORD
1999 OCT 15 AM 8:03

11284

Register of Deeds Stamp & File Number

4. Lot No. _____, Recorded Plat _____
5. Private Claims _____

I, Randy Kolehouse, in a field survey on January 11 19 99, do hereby certify that under requirements of P.A. 74 Michigan P.A. of 1970, the corner points mentioned in lines 1 and 2 above were in conformance with regulations and rules therefore as required in the current manual of survey instructions of the United States Department of the interior, Bureau of Land Management or by a decree of a Court of Law and/or that the corner points mentioned in lines 3, 4 and 5 above were in conformance with the rules of the Michigan Board of Land Surveyors or by a Decree of a Court of Law; established, re-established, monumented, re-monumented, recovered, found as expressed below:

NOTE: Not more than 4 corners, all in the same town and range, may be recorded on this certificate.

A. Description of original monument and accessories and/or subsequent restoration:

C-9	1837	G.L.O. Notes	Cathcart	Set Post
	1960	Witness Map	K.C. Surveyor	Iron & Monument Box
	1972	L.C.R.C. #211	Exxel Engineering	1/2" Iron
	1982	L.C.R.C. #2985	Jonker Land Survey	Fnd. 1/2" Iron in Mon. Box / Set K.C. Monument in Mon. Box
	1988	L.C.R.C. #4804	Olson, Meyer & May	K.C. Monument in Mon. Box

This corner was originally approved by the Kent County Remonumentation Peer Group and monumented by Rob Jonker on 7/8/82 and was recorded per L.C.R.C. #2985.

B. Description of corner evidence found and/or method applied in restoring or reestablishing corner:

- C-9 Found a Standard Kent County Monument in a monument box at the C/L intersection of 12 Mile Road (bit.) running East and West and Courtland Avenue (bit.) running North and South per L.C.R.C.'s #2985 and 4804 as set by Rob Jonker in place of a 1/2" iron he found in a monument box which checks L.C.R.C. #211 and the K.C. Surveyor's records.

L.C.R.C. #2985

Remon. tag on SE side p.pole N30°E 55.70'
Remon. tag on E side 30" Maple N20°W 67.56'
Chisled "X" on E end culvert S20°E 59.0'
Chisled "X" on W end culvert S25°W 60.3'
On C/L "X" pavement.

L.C.R.C. #4804

Remon tag & nail on SE sde P pole N 30 E 55.70' (m. 55.72')
Remon tag & nail on E sde 32" Maple N 20 W 67.56' (m. 67.59')
Chisled "X" on E end culvt. S 20 E 59.0' (m. 59.02')
Chisled "X" on W end culvt. S 25 W 60.3' (m. 60.31')
On C/L "X" pavt.

The selected location is accepted by me and is generally accepted by professional surveyors as the best available evidence of the position of the original corner.

C. Description of monument for corner and accessories established to perpetuate locating the position of the corner:


- C-9 Standard Kent County Monument in a Monument Box

"X" cut on top E end conc. culvert S 20° E 59.02'
"X" cut on top W end conc. culvert S 25° W 60.31'
Nail & K.C. remon. tag on SE side P. pole N 30° E 55.72'
Nail & K.C. remon. tag on E side 32" Maple n 20° W 67.59'
On C/L "X" of bit. roads running N-S & E-W

P.A. 345 1990 KENT COUNTY

PEER APPROVED 2/25/99

CHAIRMAN *[Signature]*

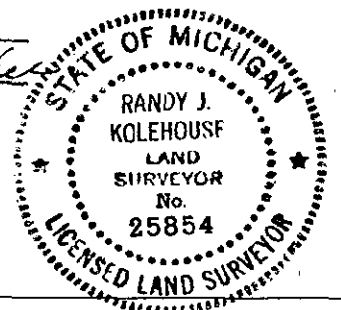

Signed by

[Signature: Randy J. Kolehouse]
EARTH TECH

Date

3/30/99

Surveyor's Michigan License No.

25854