

**SURVEY &
REMONUMENTATION**

MAY 22 2000

~~\$7.00~~
~~\$2.00~~

SECTION

**LAND CORNER RECORDATION CERTIFICATE
Filing Requirement of Act 74, Mich. P.A. 1970
KENT COUNTY REMONUMENTATION**

For corners in

<u>Kent</u> (County)	Located in: Courtland Township	Corner Code #	
1. Public Land Survey	T <u>9N</u> R <u>10W</u>	<u>C-10</u>	
	T _____ R _____	_____	
	T _____ R _____	_____	
	T _____ R _____	_____	
2. Property Controlling in Section	S _____ T _____ R _____	_____	
	S _____ T _____ R _____	_____	
3. Miscellaneous Property in Sec.	S _____ T _____ R _____	_____	
	S _____ T _____ R _____	_____	

REG. OF DEEDS

[Signature]

STATE OF MICHIGAN
COUNTY OF KENT
RECEIVED FOR RECORD
1999 OCT 15 AM 8:03


11285

Register of Deeds Stamp & File Number

4. Lot No. _____, Recorded Plat _____
5. Private Claims _____

I, Randy Kolehouse, in a field survey on January 5 19 99, do hereby certify that under requirements of P.A. 74 Michigan P.A. of 1970, the corner points mentioned in lines 1 and 2 above were in conformance with regulations and rules therefore as required in the current manual of survey instructions of the United States Department of the interior, Bureau of Land Management or by a decree of a Court of Law and/or that the corner points mentioned in lines 3, 4 and 5 above were in conformance with the rules of the Michigan Board of Land Surveyors or by a Decree of a Court of Law; established, re-established, monumented, re-monumented, recovered, found as expressed below:

NOTE: Not more than 4 corners, all in the same town and range, may be recorded on this certificate.

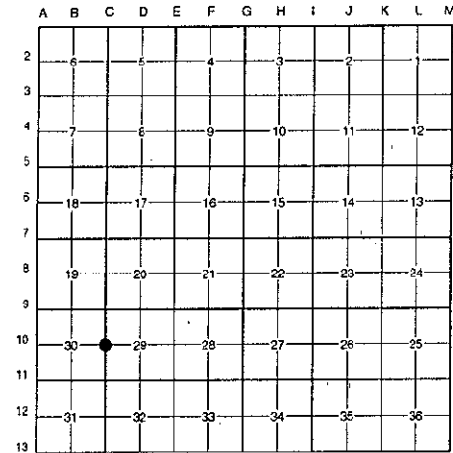

A. Description of original monument and accessories and/or subsequent restoration:

C-10 1837	G.L.O. Notes	Cathcart	Set Post
1965	Witness Map	K.C. Surveyor	3/4" Iron
1972	L.C.R.C. #211	Exxel Engineering	1/2" Iron
1982	L.C.R.C. #2977	Jonker Land Survey	Fnd. 1/2" Iron / Set K.C. Monument
1988	L.C.R.C. #4805	John Bueche	K.C. Monument

This corner was originally approved by the Kent County Remonumentation Peer Group and monumented by Rob Jonker on 7/1/82 and was recorded per L.C.R.C. #2977.

B. Description of corner evidence found and/or method applied in restoring or reestablishing corner:

C-10 Found a Standard Kent County Monument 1.0' South of fence lines running North, South, East and West, on line of a tree row running North, and 60.0' ± South of the C/L of a creek per L.C.R.C.'s #2977 and #4805 as set by Rob Jonker in place of a 1/2" iron he found which checked L.C.R.C. #211 and the K.C. Surveyor's records.

L.C.R.C. #2977

L.C.R.C. #4805

Remon. tag on NW side 9" Oak N40°E 30.24'
Remon. tag on E side 12" Basswood S30°W 11.28'
Remon. tag on S side fe. Post East 6.27'
C/L creek North 60' m/l
Corner is 1'S of 4-way fence corner.

Nail & Remon tag on NW sde 12" Elm N 40 E 30.15' (m. 30.24')
Nail & Remon tag on E sde 14" Basswood S 30 W 11.28'
Nail & Remon tag on S sde fence post E 6.27' (m. 6.32')
C/L creek N 60' M/L
Cor is 1'S of 4-way fence cor

The selected location is accepted by me and is generally accepted by professional surveyors as the best available evidence of the position of the original corner.

C. Description of monument for corner and accessories established to perpetuate locating the position of the corner:

C-10 Standard Kent County Monument

Nail & K.C. remon. tag on NW side 12" Elm N 40° E 30.24'
Nail & K.C. remon. tag on E side 14" Basswood S 30° W 11.28'
Nail & K.C. remon. tag on S side fence post n 90° E 6.32'
Nail & K.C. remon. tag on E side 10" Elm N 00° E 43.77'
"X" of fence lines running N-S & E-W, North 1.0'
On tree row running North
C/L of creek, North 60.0' ±

P.A. 345 1990 KENT COUNTY

PEER APPROVED 2/29/99

CHAIRMAN [Signature]

Date 3/30/99



Signed by [Signature]

EARTH TECH

Surveyor's Michigan License No. 25854