

MAY 22 2000

7.00
2.00

SECTION

LAND CORNER RECORDATION CERTIFICATE
Filing Requirement of Act 74, Mich. P.A. 1970
KENT COUNTY REMONUMENTATION

For corners in

Kent (County)	Located in:	Courtland Township	Corner Code #
1. Public Land Survey	T <u>9N</u> R <u>10W</u>		<u>C-11</u>
	T _____ R _____		_____
	T _____ R _____		_____
	T _____ R _____		_____
2. Property Controlling in Section	S _____ T _____ R _____		_____
	S _____ T _____ R _____		_____
3. Miscellaneous Property in Sec.	S _____ T _____ R _____		_____
	S _____ T _____ R _____		_____

REG. OF DEEDS


[Signature]

STATE OF MICHIGAN
COUNTY OF KENT
RECEIVED FOR RECORD
1999 OCT 15 AM 8:03

11286

Register of Deeds Stamp & File Number

- 4. Lot No. _____, Recorded Plat _____
- 5. Private Claims _____

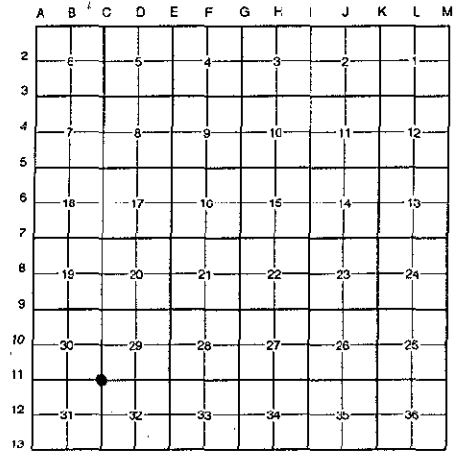

I, Randy Kolehouse, in a field survey on January 5 19 99, do hereby certify that under requirements of P.A. 74 Michigan P.A. of 1970, the corner points mentioned in lines 1 and 2 above were in conformance with regulations and rules therefore as required in the current manual of survey instructions of the United States Department of the Interior, Bureau of Land Management or by a decree of a Court of Law and/or that the corner points mentioned in lines 3, 4 and 5 above were in conformance with the rules of the Michigan Board of Land Surveyors or by a Decree of a Court of Law; established, re-established, monumented, re-monumented, recovered, found as expressed below:

NOTE: Not more than 4 corners, all in the same town and range, may be recorded on this certificate.

A. Description of original monument and accessories and/or subsequent restoration:

C-11	1837	G.L.O. Notes	Cathcart	Set Post
	1942	Witness Map	K.C. Surveyor	Mon. Box
	1971	L.C.R.C. #79	Williams & Works	1-1/4" Iron in Mon. Box
	1982	L.C.R.C. #2974	Jonker Land Survey	Fnd. 1-1/4"x24" Iron in Mon. Box / Set K.C. Monument in Mon. Box
	1988	L.C.R.C. #4806	Olson, Meyer & May	K.C. Monument in Mon. Box

This corner was originally approved by the Kent County Remonumentation Peer Group and monumented by Rob Jonker on 7/12/82 and was recorded per L.C.R.C. #2974.

B. Description of corner evidence found and/or method applied in restoring or reestablishing corner:

C-11 Found a Standard Kent County Monument 1.5' ± South of the C/L of 11 Mile Road (bit.) running East and West, on line of a fence line and tree row running North, per L.C.R.C.'s #2974 and #4806 as set by Rob Jonker in place of a 1-1/4" x 24" crimped iron he found in a monument box which checked L.C.R.C. #79 and the K.C. Surveyor's records.

L.C.R.C. #2974

L.C.R.C. #4806

P.K. nail on top fence post N70°E 69.54'
Remon. tag on N side 20" Willow S65°E 53.03'
Remon. tag on S side 22" Hickory N75°W 117.71'
"T" iron N 33.04'

P.K. nail on top fence post N 70 E 69.54' (m. 69.57')
Remon tag & nail on N sde 22" Willow S 65 E 53.01' (m. 53.06')
Remon tag & nail on S sde 24" Hickory N 75 W 117.71' (m. 117.67')
"T" iron N 33.04' (m. 33.24')
C/L E-W pvt. 1'5N
On tree & fence row N

The selected location is accepted by me and is generally accepted by professional surveyors as the best available evidence of the position of the original corner.

C. Description of monument for corner and accessories established to perpetuate locating the position of the corner:

C-11 Standard Kent County Monument in a Monument Box

- Nail & K.C. remon. tag on N side 23" Willow S 65° E 53.06'
- Nail & K.C. remon. tag on S side 26" Hickory N 75° W 117.67'
- Nail & K.C. remon. tag on E side 12" Box Elder N 10° W 24.97'
- Nail & K.C. remon. tag on W side 10" Oak S 25° W 42.21'
- PK nail top fence post N 70° E 69.57'
- "T" iron North 33.24'
- C/L of bit. road running E-W, North 1.5' ±
- On fence line and tree row running N

P.A. 343 100- KENT COUNTY
PEER APPROVED 2/25/99
CHAIRMAN [Signature]



Signed by Randy J. Kolehouse
EARTH TECH

Date 3/30/99

Surveyor's Michigan License No. 25854