

\$7.00
\$2.00

MAY 22 2000

LAND CORNER RECORDATION CERTIFICATE
Filing Requirement of Act 74, Mich. P.A. 1970
KENT COUNTY REMONUMENTATION

STATE OF MICHIGAN
COUNTY OF KENT
RECEIVED FOR RECORD
1999 OCT 15 AM 8:03

REG. OF DEEDS
[Signature]

11287

Register of Deeds Stamp & File Number

SECTION

For corners in Kent (County) Located in: Courtland Township Corner Code #

1. Public Land Survey	T <u>9N</u> R <u>10W</u>	C-12
	T _____ R _____	_____
	T _____ R _____	_____
	T _____ R _____	_____
2. Property Controlling in Section	S _____ T _____ R _____	_____
	S _____ T _____ R _____	_____
3. Miscellaneous Property in Sec.	S _____ T _____ R _____	_____
	S _____ T _____ R _____	_____

4. Lot No. _____, Recorded Plat _____

5. Private Claims _____

I, Randy Kolehouse, in a field survey on February 9 19 99, do hereby certify that under requirements of P.A. 74 Michigan P.A. of 1970, the corner points mentioned in lines 1 and 2 above were in conformance with regulations and rules therefore as required in the current manual of survey instructions of the United States Department of the interior, Bureau of Land Management or by a decree of a Court of Law and/or that the corner points mentioned in lines 3, 4 and 5 above were in conformance with the rules of the Michigan Board of Land Surveyors or by a Decree of a Court of Law; established, re-established, monumented, re-monumented, recovered, found as expressed below:

NOTE: Not more than 4 corners, all in the same town and range, may be recorded on this certificate.

A. Description of original monument and accessories and/or subsequent restoration:

C-12	1837	G.L.O. Notes	Cathcart	Set Post
	1956	Witness Map	K.C. Surveyor	Stone
	1971	L.C.R.C. #79	Williams & Works	Stone
	1980	L.C.R.C. #1719	Williams & Works	Fnd. Pointed Stone / Set K.C. Monument
	1988	L.C.R.C. #4807	John Bueche	K.C. Monument

This corner was originally approved by the Kent County Remonumentation Peer Group and monumented by Williams & Works on 12/26/80 and was recorded per L.C.R.C. #1719.

B. Description of corner evidence found and/or method applied in restoring or reestablishing corner:

C-12 Found a Standard Kent County Monument 8" below grade (in golf course) on line of a fence line running East and West per L.C.R.C.'s #1719 and #4807 as set by Williams & Works in place of a pointed stone they found which checked L.C.R.C. #79 and the K.C. Surveyor's records.


L.C.R.C. #1719	L.C.R.C. #4807
Nail & K.C. Remon. Tag N Side 18" Ash S 45°E 85.16'	Nail & K.C. Remon tag N sde 20" Ash S 45 E 85.16' (m. 85.05')

P.A. 345 1990 KENT COUNTY
PEER APPROVED 12/25/99
CHAIRMAN [Signature]

The selected location is accepted by me and is generally accepted by professional surveyors as the best available evidence of the position of the original corner.

C. Description of monument for corner and accessories established to perpetuate locating the position of the corner:

- C-12 Standard Kent County Monument (8" below grade)
- Nail & K.C. remon. tag on N side 28" Ash S 45° E 85.05'
 - Nail & K.C. remon. tag on SE side 8" Poplar N 45° E 28.32'
 - Nail & K.C. remon. tag on N side 16" Pine (8' up) West 64.81'
 - Nail & K.C. remon. tag on W side 10" Sugar Maple (6' up) S 50° W 51.33'
 - Nail & K.C. remon. tag on S side 12" Box Elder (5' up) East 63.10'
 - On fence line running E-W

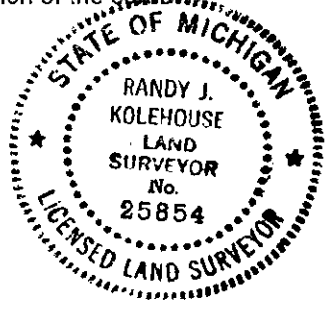

Signed by Randy J. Kolehouse
EARTH TECH

Date 3/30/99

Surveyor's Michigan License No. 25854