

\$7.00  
\$2.00

MAY 22 2000

LAND CORNER RECORDATION CERTIFICATE  
Filing Requirement of Act 74, Mich. P.A. 1970  
KENT COUNTY REMONUMENTATION

STATE OF MICHIGAN  
COUNTY OF KENT  
RECEIVED FOR RECORD  
1999 OCT 15 AM 8:03  
REG. OF DEEDS

SECTION

For corners in

Kent (County)	Located in: Courtland Township	Corner Code #
1. Public Land Survey	T <u>9N</u> R <u>10W</u>	<u>D-2</u>
	T _____ R _____	_____
	T _____ R _____	_____
	T _____ R _____	_____
2. Property Controlling in Section	S _____ T _____ R _____	_____
	S _____ T _____ R _____	_____
3. Miscellaneous Property in Sec.	S _____ T _____ R _____	_____
	S _____ T _____ R _____	_____

11289

Register of Deeds Stamp & File Number

- 4. Lot No. \_\_\_\_\_, Recorded Plat \_\_\_\_\_
- 5. Private Claims \_\_\_\_\_

I, Randy Kolehouse, in a field survey on January 25 19 99, do hereby certify that under requirements of P.A. 74 Michigan P.A. of 1970, the corner points mentioned in lines 1 and 2 above were in conformance with regulations and rules therefore as required in the current manual of survey instructions of the United States Department of the interior, Bureau of Land Management or by a decree of a Court of Law and/or that the corner points mentioned in lines 3, 4 and 5 above were in conformance with the rules of the Michigan Board of Land Surveyors or by a Decree of a Court of Law; established, re-established, monumented, re-monumented, recovered, found as expressed below:

**NOTE:** Not more than 4 corners, all in the same town and range, may be recorded on this certificate.


A. Description of original monument and accessories and/or subsequent restoration:

D-2 This corner was not originally set by the G.L.O.

No information on record.

B. Description of corner evidence found and/or method applied in restoring or reestablishing corner:

D-2 Found a G. Hackbart capped iron #25844 1' South of a fence line and tree row running East and West and 10' ± East of a tree row running North as set by G. Hackbart at the intersection of 1/4 lines. The capped iron is 0.1' North and 0.1' West of the intersection of 1/4 lines. Accepted the capped iron as Center of Section.

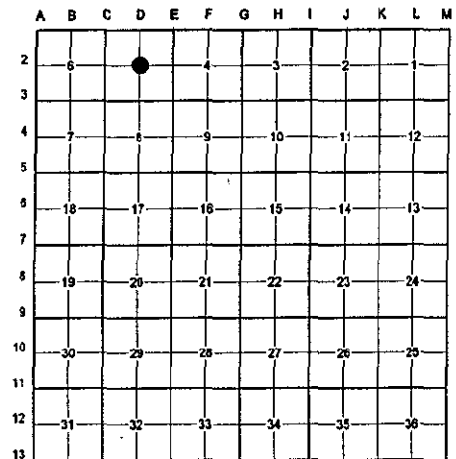


P.A. 345 1990 KENT COUNTY  
PEER APPROVED 2/25/99  
CHAIRMAN [Signature]

The selected location is accepted by me and is generally accepted by professional surveyors as the best available evidence of the position of the original corner.

C. Description of monument for corner and accessories established to perpetuate locating the position of the corner:

D-2 Replaced Capped Iron with a Standard Kent County Monument

- Nail & K.C. remon. tag on N side 10" Elm N 90° E 19.28'
- Nail & K.C. remon. tag on E side triple 12" Apple N 15° W 13.72'
- Nail & K.C. remon. tag on S side RR tie fence post N 85° W 21.20'
- Nail & K.C. remon. tag on E side 6" Elm N 20° E 23.42'
- Fence line and tree row running E-W, North 1.0'
- Tree row running N, West 10.0'

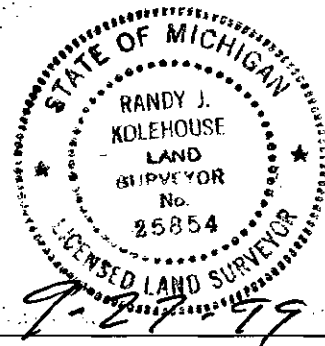

Signed by [Signature] Date 9-27-99

WILLIAMS & WORKS

Surveyor's Michigan License No. 25854