

MAY 22 2000

\$7.00  
\$2.00

SECTION

LAND CORNER RECORDATION CERTIFICATE  
Filing Requirement of Act 74, Mich. P.A. 1970  
KENT COUNTY REMONUMENTATION

For corners in

Kent (County)	Located in: Courtland Township	Corner Code #
1. Public Land Survey	T <u>9N</u> R <u>10W</u>	<u>D-3</u>
	T _____ R _____	_____
	T _____ R _____	_____
	T _____ R _____	_____
2. Property Controlling in Section	S _____ T _____ R _____	_____
	S _____ T _____ R _____	_____
3. Miscellaneous Property in Sec.	S _____ T _____ R _____	_____
	S _____ T _____ R _____	_____

REG. OF DEEDS

*[Handwritten Signature]*

STATE OF MICHIGAN  
COUNTY OF KENT  
RECEIVED FOR RECORD  
1999 OCT 15 AM 8:04

11290

Register of Deeds Stamp & File Number

- 4. Lot No. \_\_\_\_\_, Recorded Plat \_\_\_\_\_
- 5. Private Claims \_\_\_\_\_


I, Randy Kolehouse, in a field survey on January 25 19 99, do hereby certify that under requirements of P.A. 74 Michigan P.A. of 1970, the corner points mentioned in lines 1 and 2 above were in conformance with regulations and rules therefore as required in the current manual of survey instructions of the United States Department of the Interior, Bureau of Land Management or by a decree of a Court of Law and/or that the corner points mentioned in lines 3, 4 and 5 above were in conformance with the rules of the Michigan Board of Land Surveyors or by a Decree of a Court of Law; established, re-established, monumented, re-monumented, recovered, found as expressed below:

**NOTE: Not more than 4 corners, all in the same town and range, may be recorded on this certificate.**

A. Description of original monument and accessories and/or subsequent restoration:

D-3	1837	G.L.O. Notes	Cathcart	Set Post
	1983	L.C.R.C. #3407	Glaza & Associates	N/A
	N/A	Notes	Moore & Bruggink	3/4" Iron
	1984	L.C.R.C. #4018	John Bueche	Fnd. 3/4" Iron / Set K.C. Monument
	1988	L.C.R.C. #4809	Olson, Meyer & May	K.C. Mon

P.A. 345 1990 KENT COUNTY  
PEER APPROVED 2/25/99  
CHAIRMAN [Signature]

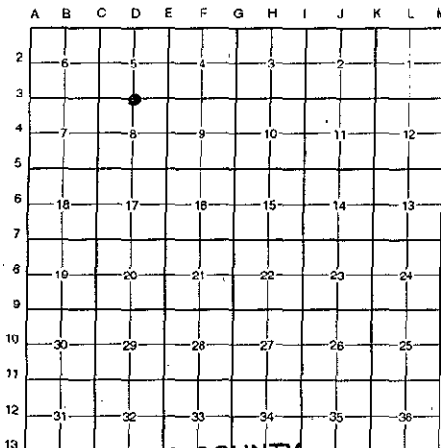

This corner was originally approved by the Kent County Remonumentation Peer Group and monumented by John Bueche on 11/7/84 and was recorded per L.C.R.C. #4018.

B. Description of corner evidence found and/or method applied in restoring or reestablishing corner:

D-3 Found a Standard Kent County Monument in a monument box 2.0' ± North of the C/L of 15 Mile Road (bit.) running East and West, on line of a tree row running South and a fence line running North, per L.C.R.C.'s #4018 and #4809 as set by John Bueche in place of a 3/4" iron he found which checked L.C.R.C. #3407 and the notes of Moore & Bruggink.

L.C.R.C. #4018

L.C.R.C. #4809

K.C. Remon. tag & nail in W. side 18" Maple S 0° E 39.51'  
K.C. Remon. tag & nail in E. side Power pole S 30° E 56.86'  
K.C. Remon. tag & nail in E. side Power pole N 0° E 45.28'  
SW cor. foundation to garage N 40° E 142.70'  
C/L blacktop E-W is South 2'+/-

K.C. Remon tag & nail in W sde 20" Maple S 0 E 39.51' (m. 39.49')  
K.C. Remon tag & nail in E sde P pole S 30 E 56.86' (m. 56.98')  
K.C. Remon tag & nail in E sde P pole N 0 E 45.28' (m. 45.33')  
SW cor fndn to garage N 40 E 142.70' (m. 142.65')  
C/L bit E-W is S 2' M/L

The selected location is accepted by me and is generally accepted by professional surveyors as the best available evidence of the position of the original corner.

C. Description of monument for corner and accessories established to perpetuate locating the position of the corner:

D-3 Standard Kent County Monument in a Monument Box

Nail & K.C. remon. tag on W side 22" Maple S 00° E 39.49'  
Nail & K.C. remon. tag on E side P. pole S 30° E 56.98'  
Nail & K.C. remon. tag on E side 6" Pine N 40° E 35.83'  
Nail & K.C. remon. tag on E side P. pole N 00° E 45.33'  
Capped iron #31604 N 00° E 32.98'  
Capped iron #9548 S 00° E 32.98'

C/L of bit. road running E-W, South 2.0'  
On tree row running S  
On fence line running N

Signed by

[Signature]  
EARTH TECH

Date

3/30/99

Surveyor's Michigan License No.

25854

